

The Board of Supervisors met on 2/25/20 at 10:00 a.m. in the Story County Administration Building. Members present: Linda Murken, Lisa Heddens and Lauris Olson, with Murken presiding. (all audio of meetings available at [storycountyia.gov](http://storycountyia.gov))

**ADOPTION OF AGENDA:** Heddens moved, Olson seconded adopting the agenda as presented. Motion carried unanimously (MCU) on a roll call vote.

**BID OPENING FOR BRIDGE REPLACEMENT PROJECTS ON 690<sup>TH</sup> AVENUE IN SECTION 20-85-21 (LLIN20—73-85) AND ON 720<sup>TH</sup> AVENUE OVER A SMALL STREAM ON THE WEST LINE OF SECTION 26 OF T82N-R21W (L-C26—73-85)** – Engineer Darren Moon and Assistant Engineer Tyler Sparks opened bids. Sparks noted this bid is for two linked projects. The following bids were opened: Peterson Contractors, Inc., Reinbeck, Iowa, bid bond signed and attached, first project \$156,832.25, second project \$76,675.90; Progressive Structures, LLC, Elkader, Iowa, bid bond signed and attached, first project \$145,892.50, second project \$76,121.15; Reilly Construction, Ossian, Iowa, bid bond signed and attached, first project \$171,593.40, second project \$84,403.00.

**BID OPENING FOR PAVEMENT PROJECTS ON 535<sup>TH</sup> AVENUE FROM 320<sup>TH</sup> STREET SOUTH 0.25 MILES ON CENTER OF SECTION 27 OF T82N R24W (PALESTINE TOWNSHIP) (L-P27—73-85)** – Engineer Darren Moon and Assistant Tyler Sparks opened the following bids: InRoads, LLC, Des Moines, Iowa bid bond signed and attached, \$193,417.70; Manatts, Brooklyn, Iowa, bid bond signed and attached, \$146,101.80.

**BID OPENING FOR RESURFACING PROJECT ON 680<sup>TH</sup> AVENUE FROM 255<sup>TH</sup> STREET NORTH 1.6 MILES TO US HIGHWAY 30 (LFM-(HG)—7X-85); AND 2.54 ON HICKORY GROVE LAKE LOOP IN SECTION 24 OF T83N R22W (NEVADA TOWNSHIP) (L-HG2—73-85)** – Engineer Darren Moon and Assistant Engineer Tyler Sparks opened the following bids: Manatts, Brooklyn, Iowa, bid bond signed and attached, first part \$331,933.96, second part \$512,800.12. One bid for this project. Total: \$844,734.20

**BID OPENING FOR THE CULVERT REPLACEMENT PROJECT ON 645<sup>TH</sup> AVENUE OVER A SMALL STREAM IN SECTION 21-82-22 (L-IC21—73-85)** – Engineer Darren Moon and Assistant Engineer Tyler Sparks opened the following bids: Gehrke, Inc., Eldora, Iowa, bid bond signed and attached, \$66,000.80; Reilly Construction, Ossian, Iowa, bid bond signed and attached, \$60,778.50; Progressive Structures, LLC, Elkader, Iowa, bid bond signed and attached, \$61,707.10; Peterson Contractors, Inc., Reinbeck, Iowa, bid bond signed and attached, \$58,679.62.

Moon and Sparks will return to make recommendations of awarding bids at the March 3 meeting. Murken thanked them both.

**MINUTES:** 2/18/20 Minutes – will be considered next week

**PERSONNEL ACTIONS:** Pay adjustment, effective 3/1/20, a) Community Services for Wendy Schmitz @ ~~\$18.60~~ \$19.60/hr; b) Sheriff's Office for Karissa Hendrick @ \$2,355.20/bw; c) Auditor's Office for Kristy Macki @ \$22.87/hr; d) Secondary Roads for Charles Carsrud @ \$33.19/hr. Olson moved, Heddens seconded with noted correction in hourly rate for Schmitz. Roll call vote. (MCU)

Heddens moved, Olson seconded approval of the Consent Agenda as presented.

1. Annual License and Maintenance Fees between Story County and SysAid Technologies, Ltd, effective 5/4/20-5/3/21, for \$1,200.00
2. Highway right-of-way with Marianne J Halsted for the purchase of permanent easement for \$304.36 (L-LIN20--73-85)
3. Final pay voucher for Peterson Contractors Inc, for Culvert Replacement Project #FM-C085(149)--55-85
4. Contract with Johnson Controls for fire alarm testing and inspection at the Administration Building, effective 1/1/20-12/31/20, for \$2,182.34
5. Road Closure Resolutions: #20-28, #20-29
6. Utility Permits: #20-4704, #20-4707, #20-4708, #20-4714, #20-4715, #20-4717

Roll call vote. MCU

**REQUEST BY WAYNE SELLE FOR REPAYMENT OPTIONS FOR IOWA LAW ENFORCEMENT ACADEMY (ILEA) TRAINING EXPENSES** - Alissa Wignall, Internal Operations and Human Resources Director, provided background. Selle resigned within a year of hire. Per the agreement he signed when hired, he has an obligation to repay the County. Wignall, Sheriff Fitzgerald, and Assistant County Attorney Ethan Anderson met to discuss Selle's request. The difference between Selle's letter and the Sheriff's request is the deputy uniform which is returned to the County. Olson clarified the Board is considering repayment of the funds spent on Iowa Law Enforcement Academy (ILEA) training and related expenses. Heddens asked how this type of situation is handled by other counties and law enforcement agencies. Wignall stated it varies. Olson asked if the County was requesting decertification. Wignall confirmed the County is not. Murken clarified the amount under discussion is \$8,539.00. Connie Toresdahl, Sheriff's Office, provided detail re-use of returned uniforms. Discussion took place about lump sum. Heddens moved, Murken seconded, for Selle to pay a lump sum \$8,539.00 and for Wignall to issue Selle a letter of debt satisfaction upon payment. Roll call vote. Heddens aye, Olson nay, Murken aye. Motion carries.

**INTEGRATED ROADSIDE VEGETATION MANAGEMENT (IRVM) QUARTERLY REPORT** – Joe Kooiker, Weed Commissioner reported on drainage ditch brush clearing, possibility of contracting this work, roadside spraying, new equipment, safety concerns, equipment rental, funding sources, grants, seasonal staff, and planned work for the spring and summer. The Board thanked Kooiker for his report.

**UPCOMING AGENDA ITEMS:** Olson stated Volunteer Center funding possibilities will be discussed next week. Also a conversation about having quarterly reports from Todd Lundvall and Leanne Harter. Murken clarified Olson is requesting reports from staff, not department heads.

**LIAISON ASSIGNMENTS, COMMITTEE MEETINGS UPDATES, AND ANNOUNCEMENTS**

**FROM THE SUPERVISORS:** All Board members reported on multiple meetings.

Olson moved, Heddens seconded to adjourn at 11:04 a.m. Roll call vote. (MCU)

2/25/20

Story County  
Board of Supervisors Meeting  
Agenda

1. CALL TO ORDER: 10:00 A.M.

2. PLEDGE OF ALLEGIANCE:

3. ADOPTION OF AGENDA:

4. PUBLIC COMMENT #1:

This comment period is for the public to address topics on today's agenda

5. Bid Opening For Bridge Replacement Projects On 690th Ave. In Section 20-85-21 (L-LIN20—73-85) And On 720th Ave; Over A Small Stream On The West Line Of Section 26 Of T82N-R21W (L-C26—73-85)

Department Submitting Engineer

6. Bid Opening For Pavement Projects On 535th Ave. From 320th St. South 0.25 Miles On Center Of Section 27 Of T82N R24W (Palestine Township) (L-P27—73-85)

Department Submitting Engineer

7. Bid Opening For Resurfacing Project On 680th Ave., From 255th St., North 1.6 Mile To Highway 30 (LFM-(HG)—7X-85); And On Hickory Grove Lake Loop, 2.54 Miles, In Section 24 Of T83N R22W (Nevada Township) (L-HG2—73-85)

Department Submitting Engineer

8. Bid Opening For The Culvert Replacement Project On 645th Ave. Over Small Stream; In Section 21-82-22 (L-IC21—73-85)

Department Submitting Engineer

9. AGENCY REPORTS:

10. CONSIDERATION OF MINUTES:

I. 2/18/20 Minutes

Department Submitting Auditor

11. CONSIDERATION OF PERSONNEL ACTIONS:

I. Action Forms

Pay adjustment, per union contract, effective 3/1/20, in Community Services for Wendy Schmitz @ \$18.60 per hour; in Sheriff's Office for Karissa Hendrick @ \$2,355.20 bw; in Auditor's Office for Kristy Macki @ \$22.87 per hour; in Secondary Roads for Charles Carsrud @ \$33.19 per hour

Department Submitting HR

12. CONSENT AGENDA:

(All items listed under the consent agenda will be enacted by one motion. There will be no separate discussion of these items unless a request is made prior to the time the Board votes on the motion.)

- I. Consideration Of Annual License And Maintenance Fees Between Story County And SysAid Technologies, Ltd Effective 5/4/2020 - 5/3/2021 For \$1,200.00

Department Submitting Information Technology

Documents:

SYSAID PROPOSAL.PDF

- II. Consideration Of Highway Right Of Way With Marianne J Halsted For The Purchase Of Permanent Easement For \$304.36 (L-LIN20--73-85)

Department Submitting Engineer

Documents:

ROW CTR HALSTED.PDF

- III. Consideration Of Final Pay Voucher For Peterson Contractors Inc, For Culvert Replacement Project #FM-C085(149)--55-85

Department Submitting Engineer

Documents:

FPV PETERSON CONTRACTORS.PDF

- IV. Consideration Of Contract With Johnson Controls For Fire Alarm Testing And Inspection At Administration Building, Effective 1/1/20-12/31/20, For \$2,182.34

Department Submitting Facilities Management

Documents:

JOHNSON ADMIN.PDF

- V. Consideration Of Road Closure Resolution(S): #20-28, #20-29

Department Submitting Engineer

Documents:

RC 20 29.PDF  
RC 20 28.PDF

- VI. Consideration Of Utility Permit(S): #20-4704, 20-4707, 20-4708, 20-4714, 20-4715,20-4717

Department Submitting engineer

Documents:

UT 20 4708.PDF  
UT 20 4707.PDF  
UT 20 4704.PDF  
UT 20 4717.PDF  
UT 20 4715.PDF  
UT 20 4714.PDF

13. PUBLIC HEARING ITEMS:

14. ADDITIONAL ITEMS:

- I. Discussion And Consideration Of Request By Wayne Selle For Repayment Options For ILEA Training Expenses - Alissa Wignall

Department Submitting Board of Supervisors

Documents:

BOARD OF SUPERVISORS LETTER.PDF  
SHERIFF MEMO.PDF

15. DEPARTMENTAL REPORTS:

- I. IRVM Quarterly Report - Joe Kooiker

Department Submitting Auditor

Documents:

IRVM.PDF

16. OTHER REPORTS:

17. UPCOMING AGENDA ITEMS:

18. PUBLIC FORUM #2:

Comments from the Public on Items not on this Agenda. The Board may not take any Action on the Comments due to the Requirements of the Open Meetings Law, but May Do So In the Future.

19. LIAISON ASSIGNMENTS, COMMITTEE MEETINGS UPDATES, AND ANNOUNCEMENTS FROM THE SUPERVISORS:

20. ADJOURNMENT:

Story County strives to ensure that its programs and activities do not discriminate on the basis of race, color, national origin, sex, age or disability. Persons requiring assistance, auxiliary aids or services, or accommodation because of a disability may contact the county's ADA coordinator at (515) 382-7204.

Story County  
Board of Supervisors  
Tentative Agenda  
2/25/20

NAME

ADDRESS

Jane Penke  
Tyler Sparks  
Cyrne Jourdahl  
Khalida  
Missalyn  
Dustin Ogram  
Jordan  
Sandra King  
Ted Rasmussen

Nevada  
Engineer's office  
Sheriff's office  
BOS  
Bos  
AFDC  
IDUR  
BOS  
Treasurer



www.sysaid.com

Tuesday, February 18, 2020

# OP-0640820

# Cost Proposal

For: Story County

Account Name: storycounty1813830702

Order includes:	TOTAL COST
<b>SysAid (On-Premise, Fusion) Basic</b> ✓ 6 Administrators ✓ Unlimited(∞) End Users ✓ 500 Assets ✓ 1 Remote Control Gateway channel ✓ 1 My Desktop channel	\$1,200 (USD) <div style="background-color: #808080; color: white; padding: 10px; text-align: center; width: fit-content; margin: 10px auto;">Proceed Now</div>

Your SysAid license for account name "storycounty1813830702" will be renewed from May 04, 2020 until May 03, 2021.

#	Item Details	Unit Cost	Units	Duration	Cost
1	Maintenance Fee	\$1,200/year	1	12	\$1,200
<b>Total (USD):</b>					<b>\$1,200</b>

APPROVED  
 Initials: gmm  
 Date: 2/25/2020  
 Action: \_\_\_\_\_

~~For your attention: As of April 2017, we've updated our EULA to accommodate our new Annual Mode offering (see sections 7.1 and 7.2 in the EULA for updates).~~

### Terms of payment:

1. All prices are quoted in USD.
2. As SysAid is an international company, we do not charge VAT on our software. Depending on your chosen payment method, VAT may be applied by the payment processor as required by local law.
3. The invoice must be paid within 30 days from the date of order submission.
4. Payment by credit card, check, wire transfer, and company POs are all accepted.

5. This offer is valid until October 30, 2020.

**For payment options and submission of your PO (if relevant):**

Proceed Now

SysAid IT is a scalable solution and you have the option, at any time, to add licenses and modules, to fit your organization's specific needs.

Please contact Noy Maghilom at email: [n.maghilom@sysaid.com](mailto:n.maghilom@sysaid.com), or phone: +1 (800) 686-7047, with any questions or requests.

Prepared by: Darren R. Moon, Story County Engineer's Office, 837 N Ave., Nevada, IA 50201 515-382-7355

## CONTRACT FOR HIGHWAY RIGHT OF WAY

PARCEL No: 04-19-200-405  
 PROJECT No: L-LIN20--73-85  
 ROAD No: (690<sup>th</sup> Ave.)

THIS AGREEMENT made and entered into this 10<sup>th</sup> day of February, A.D. 2020 by and between  
**MARIANNE J. HALSTED**

Seller, and the Story County Secondary Roads Department, acting for the County of Story, Buyer.

1. a SELLER AGREES to sell and Buyer agrees to buy the following real estate, hereinafter referred to as the premises, situated in parts of the following (1/4 1/4 Sec./Twp./Rge.):

The West 27.00 feet of the East 60.00 feet of the North 100.00 feet of Lot 3 of Bryant's Subdivision in Section 19, Township 85 North, Range 21 West of the 5th P.M., Story County, Iowa. Easement contains 0.14 acres of which 0.08 acres is existing R.O.W.

County of Story, State of Iowa, and more particularly described on Page 3 and which include the following buildings, improvements and other property:

See attached graphical representation

1. b SELLER ALSO GRANTS to Buyer a temporary easement as shown on the Temporary Easement Plot attached as Page ---, and as shown on the project plans for said highway improvement. Said temporary easement shall terminate upon completion of this highway project.

1. c The premises also include all estates, rights, title and interests, including all easements, and all advertising devices and the rights to erect such devices as are located thereon. SELLER CONSENTS to any change of grade of the highway and accepts payment under this contract for any and all damages arising therefrom. SELLER ACKNOWLEDGES full settlement and payment from the Buyer for all claims per the terms of this contract and discharges the Buyer from liability because of this contract and the construction of this public improvement project.

2. Possession of the premises is the essence of this contract and Buyer may enter and assume full use and enjoyment of the premises per the terms of this contract. Buyer may take immediate possession of premises upon the execution of the contract by both Seller and Buyer.

3. Buyer agrees to pay and SELLER AGREES to grant the right of possession, convey title, and to surrender physical possession of the premises as shown:

	Payment Amount	Agreed Performance
\$	<u>304.36</u>	on right of possession
\$		on conveyance of title
\$		on surrender of possession
\$		on possession and conveyance
\$	<u>304.36</u>	<b>TOTAL LUMP SUM</b>

BREAKDOWN:	ac.=acres	sq.ft.=square feet			
Land by Fee Title		ac./sq.ft.	\$	Buildings & Improvements	\$
Underlying Fee Title		ac./sq.ft.	\$	Fence <u>---</u> rods woven	\$
Permanent Easement	<u>0.06</u>	ac./sq.ft.	\$ <u>279.36</u>	Fence <u>---</u> rods barb	\$
Temporary Easement		ac./sq.ft.	\$		
Damages for:					\$
			<u>Future Abstract Entry in the amount of \$25.00</u>		

4. The Seller is responsible for any and all matters relating to any tenant on the land and hereby releases the Buyer from all tenant liabilities.

SELLER'S SIGNATURE AND CLAIMANT'S CERTIFICATION: Upon due approval and execution by the Buyer, we the undersigned claimants certify the total lump sum payment shown herein is just and unpaid.

x Marianne Halsted  
\_\_\_\_\_  
\_\_\_\_\_

- 5. Each page and each attachment is by this reference made part hereof and the entire agreement consists of 3 pages.
- 6. In the event that said premises is burdened by the lien of a mortgage, judgement or other encumbrance, Sellers agree to fully cooperate with Buyer in securing a release of such lien from said premises, and if necessary and proper, Sellers agree that any part of the sum owing to them under this contract may be paid to the holder of such lien for such release.
- 7. Buyer agrees that any drain tile that is located within the premises and is damaged by highway construction shall be repaired at no expense to Seller. Where Buyer specifically agrees to construct and maintain fence, the fence shall be constructed and maintained for vehicle access control purposes only at no expense to the Seller. Buyer shall have the right of entry upon Sellers remaining property along the right of way line, if necessary, for the purpose of connecting said drain tile and constructing and maintaining said fence. Seller may pasture against said fence at his own risk. Buyer will not be liable for fencing private property of maintaining the same to restrain livestock.
- 8. If the Seller holds title to the premises in joint tenancy with full rights of survivorship and not as tenants in common at the time of this contract, Buyer will pay any remaining proceeds to the survivor of that joint tenancy and will accept title solely from that survivor, provided the joint tenancy has not been destroyed by operation of law or acts of the Seller.
- 9. These premises are being acquired for public purposes and this transfer is exempt from the requirements for the filing of a Declaration of Value by the Code of Iowa.
- 10. Seller states and warrants that , to the best of Seller's knowledge, there are no burial site, well, solid waste disposal site, hazardous substance, nor underground storage tank on the premises described and sought herein except,
- 11. This Written contract constitutes the entire agreement between Buyer and Seller and there is no agreement to do or not to do any act or deed except as specifically provided for herein.

**Additional Right of Way Agreements:**

**SELLER'S ACKNOWLEDGMENT**


STATE OF IOWA: ss On this 10<sup>th</sup> day of February, 20 20, before me, the undersigned, personally appeared Marianne Halsted

Known to me to be the identical persons named in and who executed the foregoing instrument and acknowledged that they executed the same as their voluntary act and deed.

Nicole Figueroa  
Notary Public for the State of Iowa

**BUYER'S APPROVAL**

Darren Moon 2-18-20  
Recommended by: Darren Moon P.E., Story County Engineer (Date)

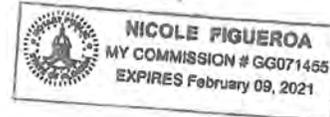

Shudakhee 2/25/20  
Approved by: Chairperson, Story County Board of Supervisors (Date)


"Exhibit A"

# STORY COUNTY SECONDARY ROADS EASEMENT ACQUISITION

PROJECT NO. L-120--73-85 PARCEL NO. 04-19-200-405  
SECTION 19, TOWNSHIP 85N, RANGE 21W, OF THE 5TH P.M., STORY COUNTY, IOWA.  
ACQUIRED FROM MARIANNE J. HALSTED

EXISTING R.O.W. 0.08 ACRES NEW R.O.W. 0.06 ACRES TOTAL R.O.W. 0.14 ACRES

The West 27.00 feet of the East 60.00 feet of the North 100.00 feet of Lot 3 of Bryant's Subdivision in Section 19, Township 85 North, Range 21 West of the 5th P.M., Story County, Iowa. Easement contains 0.14 acres of which 0.08 acres is existing R.O.W.

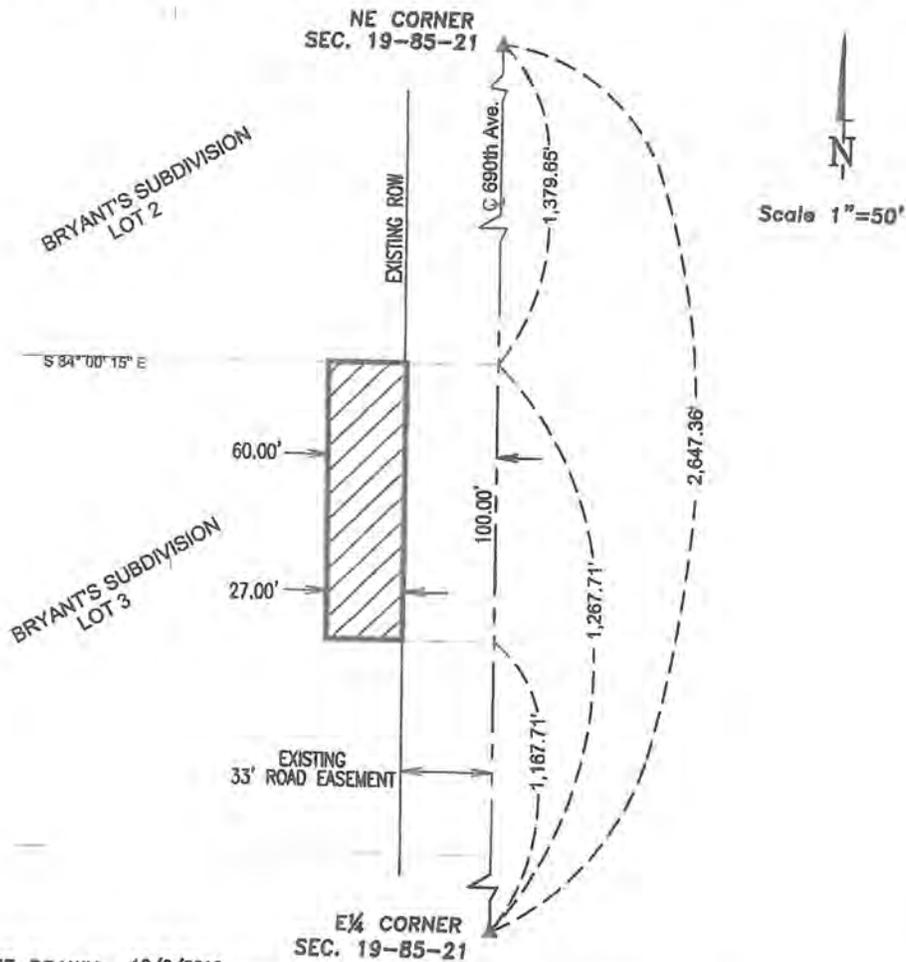

DATE DRAWN 12/2/2019

G:\Autocad\Projects\Culverts\2020\Lincoln 20 890th RCB\ROW\Halsted\Halsted Plat.dwg

Voucher No. 6



**Iowa Department of Transportation**  
**CONTRACT CONSTRUCTION PROGRESS VOUCHER**

FM-C085(149) --55-85  
 RCB Culvert - New / Replacement  
 STORY COUNTY ENGINEER

DATE LAST VOUCHER 01-14-20 THIS VOUCHER MO. DAY YR.

TO DATE	LAST VOUCH.	AUTH.	RET. %
10.0	20.0	3.000	

Contractor No. 35350 PETERSON CONTRACTORS INC REINBECK, IA

MEASURE

ITEM NO.	QUANTITY AWARDED	ITEM DESCRIPTION	FCT.	Comp. Last Voucher	RURAL		URBAN	
					PARTICIPATING	NON-PARTICIPATING	PARTICIPATING	NON-PARTICIPATING
0010	0.500	CLEAR+GRUBB	410	TOTAL TO DATE	000	500	000	000
0020	269.200	EXCAVATION, CL 10, RDWY+BORROW	410	TOTAL TO DATE	000	269200	000	000
0030	150.000	EXCAVATION, CL 10, CHANNEL	410	TOTAL TO DATE	000	150000	000	000
0040	4500.000	RMVL OF EXIST STRUCT	430	TOTAL TO DATE	000	4500000	000	000
0050	188.000	EXCAVATION, CL 20	430	TOTAL TO DATE	000	188000	000	000
0060	108.000	PRECAST CONC BOX CULV, 10'X6'	420	TOTAL TO DATE	000	108000	000	000
0070	2.000	PRECAST CONC BOX CULV ST END SEC, 10'X 6'	420	TOTAL TO DATE	000	2000	000	000
0080	1.000	PRECAST CONC BOX FLARED APRON,	420	TOTAL TO DATE	000	1000	000	000
0090	50.000	CULV, CMP ENT, 18"	420	TOTAL TO DATE	000	50000	000	000

I certify that the work items shown herein are just and unpaid, and that the requirements of the Iowa Department of Transportation specifications for this project, including all requirements as to maximum hours of labor and minimum wages have been complied with.

1. 2-20-20 DATE PROJECT ENGINEER CERTIFICATION  
Valerie Miller PROJECT ENGINEER CERTIFICATION  
 2. 2-25-2020 DATE CHAIRMAN OF BOARD OF SUPERVISORS APPROVAL  
Alma Baker CHAIRMAN OF BOARD OF SUPERVISORS APPROVAL  
 IDOT is not involved in this Farm to Market project.  
 District Construction/Local Systems Engineer or Office Director Approval  
 Project records reviewed.  
 Project records not reviewed. Recommend payment based on the project engineers certification.  
 CERTIFICATION FOR HOURS AND LABOR APPLIES ONLY TO FEDERAL PARTICIPATING PROJECT.

CLAIMANT'S CERTIFICATION (Required for Final Payment Only)  
cordell q. peterson the president

for PETERSON CONTRACTORS INC. (contractor) certify that the work items shown herein are just and unpaid, and that the requirements of the Iowa Department of Transportation specifications for this project, including all requirements as to maximum hours of labor and minimum wages have been complied with.  
2-11-2020 DATE SIGNED CLAIMANT (CONTRACTOR)  
Valerie Miller



Iowa Department of Transportation  
CONTRACT CONSTRUCTION PROGRESS VOUCHER

Contract 035647

FM-C085(149)--55-85  
RCB Culvert - New / Replacement  
STORY COUNTY ENGINEER

Voucher No. 6

DATE LAST VOUCHER MO. DAY YR. 01 -14 -20  
THIS VOUCHER MO. DAY YR.

Contractor No. 35350 PETERSON CONTRACTORS INC REINBECK, IA

ITEM NO.	QUANTITY AWARDED	UNIT OF MEASURE	ITEM DESCRIPTION	FCT.	RURAL		URBAN	
					PARTICIPATING	NON-PARTICIPATING	PARTICIPATING	NON-PARTICIPATING
0100	45.000	Linr Ft	CULV. CMP ENT, 24*	420	000	45000	000	000
0110	103.200	Sq Yard	ENGINEER FABRIC	410	000	109900	000	000
0120	98.100	Ton	REVTMENT, CLASS E	410	000	101530	000	000
0130	4.000	Each	SAFETY CLOSURE	410	000	4000	000	000
0140	2500.000	Lump Sum	TRAFFIC CONTROL	401	000	2500000	000	000
0150	9500.000	Lump Sum	MOBILIZATION	401	000	9500000	000	000
8001	144.000		EMBANKMENT-IN-PLACE	401	000	144000	000	000
8002	388.000		EXCAVATION, CLASS 10	401	000	388000	000	000
8003	2.000		SUBDRAIN OUTLET	401	000	2000	000	000

I certify that the work items shown herein are just and unpaid, and that the requirements of the Iowa Department of Transportation specifications for this project, including all requirements as to maximum hours of labor and minimum wages have been complied with.

CLAIMANT'S CERTIFICATION (Required for Final Payment Only)  
**cordell q. peterson** the **president**  
PETERSON CONTRACTORS INC.

1. DATE PROJECT ENGINEER CERTIFICATION  
2. DATE CHAIRMAN OF BOARD OF SUPERVISORS APPROVAL  
3. DATE DISTRICT CONSTRUCTION/LOCAL SYSTEMS ENGINEER OR OFFICE DIRECTOR APPROVAL

for items shown herein are just and unpaid, and that the requirements of the Iowa Department of Transportation specifications for this project, including all requirements as to maximum hours of labor and minimum wages have been complied with.  
SIGNED CLAIMANT (CONTRACTOR)  
*Cordell Q. Peterson*  
DATE 2-11-2020

CERTIFICATION FOR HOURS AND LABOR APPLIES ONLY TO FEDERAL PARTICIPATING PROJECT.





D-U-N-S 09-4738007  
FED. ID 58-2608661

District # 320  
11318 AURORA AVE  
URBANDALE, IA 50322-  
515-278-4100

Johnson Controls Fire Protection LP

INVOICE NO.  
21429484

INVOICE DATE  
01-22-20

CUSTOMER PO

CONTRACT #  
713972

MODIFIER  
R08-SEP-2017

PAYMENT TERMS  
NET 30

**Bill To:** 320-00289793  
Story Co Facilities Management  
900 6th St  
NEVADA IA 50201-2004

**Ship To:** 320-00289793  
Story Co Facilities Management  
900 6th St  
NEVADA IA 50201-2004

**Requestors Name:** AL HAHN, PROP MANAGER,

CONTRACT DESCRIPTION	CONTRACT START DATE	CONTRACT END DATE
STORY COUNTY FACILITIES MANAGEMENT 9006TH ST. 289793	01-JAN-18	31-DEC-20

INVOICE NOTES:

Annual Fire Alarm Testing and Inspection

APPROVED     DENIED  
 Member Initials: PM  
 Issuing Date: 2/25/2020  
 Follow-up action: \_\_\_\_\_

Total Contract Amount	-	\$6,547.02	Amount Of Current Invoice	-	\$2,182.34
			Sales Tax	-	\$0.00
			Total Amount Included	-	\$2,182.34
			Payment Received	-	\$0.00
<b>Total Amount Due</b>					<b>\$2,182.34</b>

REMITTANCE COPY

PLEASE TEAR OFF AND RETURN THIS PORTION WITH YOUR PAYMENT - WRITE INVOICE NO. ON YOUR CHECK.

TOTAL AMOUNT DUE  
2,182.34



**BILL TO** Story Co Facilities Management  
320-00289793  
**SHIP TO** Story Co Facilities Management  
320-00289793

INVOICE NUMBER 21429484  
INVOICE DATE 01-22-20  
CUSTOMER P.O.

**REMIT TO** Johnson Controls Fire Protection LP  
Dept. CH 10320  
Palatine, IL 60055-0320

8000218234821429484

Closure No. 20-28

Date February 19, 2020

## Resolution


### BE IT RESOLVED

By the Board of Supervisors of Story County, Iowa, to approve the road Closure(s) for the purpose of Construction in section 22 Richland on

E29 (190th St) is Closed between S27 (660th Ave) and 650th Ave

Motion by: HEDDENS Seconded by: OLSON

Olson	<u>X</u>	Aye	Heddens	<u>X</u>	Aye	Murken	<u>X</u>	Aye
		Nay			Nay			Nay
		Absent			Absent			Absent

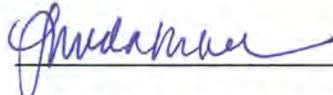

Story County Board of Supervisors

Closure No. 20-29

Date February 19, 2020

## Resolution


### BE IT RESOLVED

By the Board of Supervisors of Story County, Iowa, to approve the road Closure(s) for the purpose of Construction in section 4-5,8,9 New Albany on

Lincoln Highway is Closed at bridge over US 65

Motion by: HEDDENS Seconded by: OLSON

Olson	<input checked="" type="checkbox"/>	Aye	Heddens	<input checked="" type="checkbox"/>	Aye	Murken	<input checked="" type="checkbox"/>	Aye
	<input type="checkbox"/>	Nay		<input type="checkbox"/>	Nay		<input type="checkbox"/>	Nay
	<input type="checkbox"/>	Absent		<input type="checkbox"/>	Absent		<input type="checkbox"/>	Absent

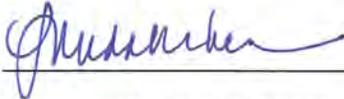

Story County Board of Supervisors

## STORY COUNTY UTILITY PERMIT

Date 2/14/20OSP-17153 Job Tract#133000469-0003

To the Board of Supervisors, Story County, Iowa:

The Windstream Iowa Communications, LLC Company, incorporated under the laws of Iowa, authorize to do business within the State of Iowa, with its principal place of business at 4001 N. Rodney Parham Road, Little Rock, AR 72212, does hereby make application requesting permission to occupy certain portions of public right-of-way and that the County Engineer be directed to establish the location of lines of transmission of bore below ditch bottoms on secondary route 305th Street, from 600th Ave to 60264 305th Street, a distance of 0.30 miles.

Agreements: The utility company, corporation, applicant, permittee, or licensee, (hereinafter referred to as the permittee) agrees that the following stipulations shall govern under this permit.

1. The Permittee will file a plat setting out the location of proposed line on the secondary route and that the description of the proposed installation including type, height, and spacing of poles, maximum voltage, lengths of cross arms, minimum clearance and number of wires, type, size and capacity of underground cables, conduits, tile lines, and pipe lines, maximum working pressures for pipe lines carrying gas or flammable petroleum products are described as follows:
2. The installation shall meet the requirements of county, state, and federal laws, franchise rules, and of the Iowa State Commerce Commission Regulations and Directives, Utilities Division, the Iowa State Department of Health, and any other laws or regulations applicable.
3. The Permittee shall be fully responsible for any future adjustments of its facilities within the established highway right-of-way caused by highway construction or maintenance operations.
4. Story County assumes no responsibility for damages to the Permittee's property occasioned by any construction or maintenance operations on said highways.
5. The Permittee shall take all reasonable precautions during the construction and maintenance of said installation to protect and safeguard the lives and property of the traveling public and adjacent property owners.
6. The Permittee, and its contractors, shall carry on the construction or repair of the accommodated utility with serious regard to the safety of the public. Traffic protection shall be in accordance with Part VI of the current Iowa Department of Transportation Manual on Uniform Control Devices for Streets and Highways.
7. The Permittee shall be responsible for any damage resulting to said highways because of the construction operation, or maintenance of said utility, and shall reimburse Story County for any expenditure the County may have to make on said highways because of said permittee's utility having been constructed, operated, and maintained thereon.
8. The Permittee shall indemnify and save harmless Story County from any and all causes of action, suits at law or in equity, or losses, damages, claims, or demands, and from any and all

liability and expense of whatsoever nature for, on account of or due to the acts or omissions of said Permittee's officers, members, agents, representatives, contractors, employees or assigns arising out of or in connection with its (or their) use or occupancy of the public highway under this permit.

9. Noncompliance with any of the terms of permit, or agreement, may be considered cause for shut down of utility construction operations, or revocation of the permit.

10. The following special requirements, if applicable, shall apply to this permit:

Whenever the route of the proposed cable line runs along a paved secondary highway, the location of said cable shall be constructed on top of the road shoulder so as to be within approximately two-feet of the pavement edge.

Whenever the route of the proposed cable line runs along a dirt or gravel surfaced highway, the location of said cable shall be constructed on top of the road surface and as near possible to the shoulder line

Whenever a cross road culvert or bridge is encountered along the route of the proposed cable lines, said cable shall be constructed around the ends of said cross road culvert or bridge even though this looping is not designated on the situation plans attached hereto.

The crossing of the cable line from one side of the highway to the other shall be accomplished at a near right angle rather than diagonally so as to disturb the roadbed of the traveled way as little as possible.

Whenever the route of the proposed cable line is to cross a paved highway, such crossing shall be in a bored hole rather than open cut trench.


Date 02/12/20

Windstream Iowa Communications, LLC  
Name of Company (Applicant - Permittee)

Deanna L. Phillips Deanna L. Phillips 501-748-9471  
by Phone no.


Recommended for Approval:

Date 2-13-20

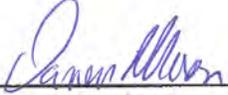 515-382-7355  
County Engineer Phone no.

Approved:

Date 2-25-2020

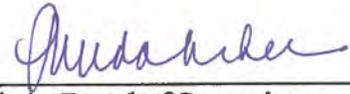  
Chair, Board of Supervisors  
Story County, Iowa

Three (3) copies of this form will be required for each installation. A plat shall be attached to each copy submitted.

Farm-to-Market Road System Map

STORY COUNTY

IOWA



PROVIDED BY


IOWADOT

NOV 14 2011

6:09

1:00 W



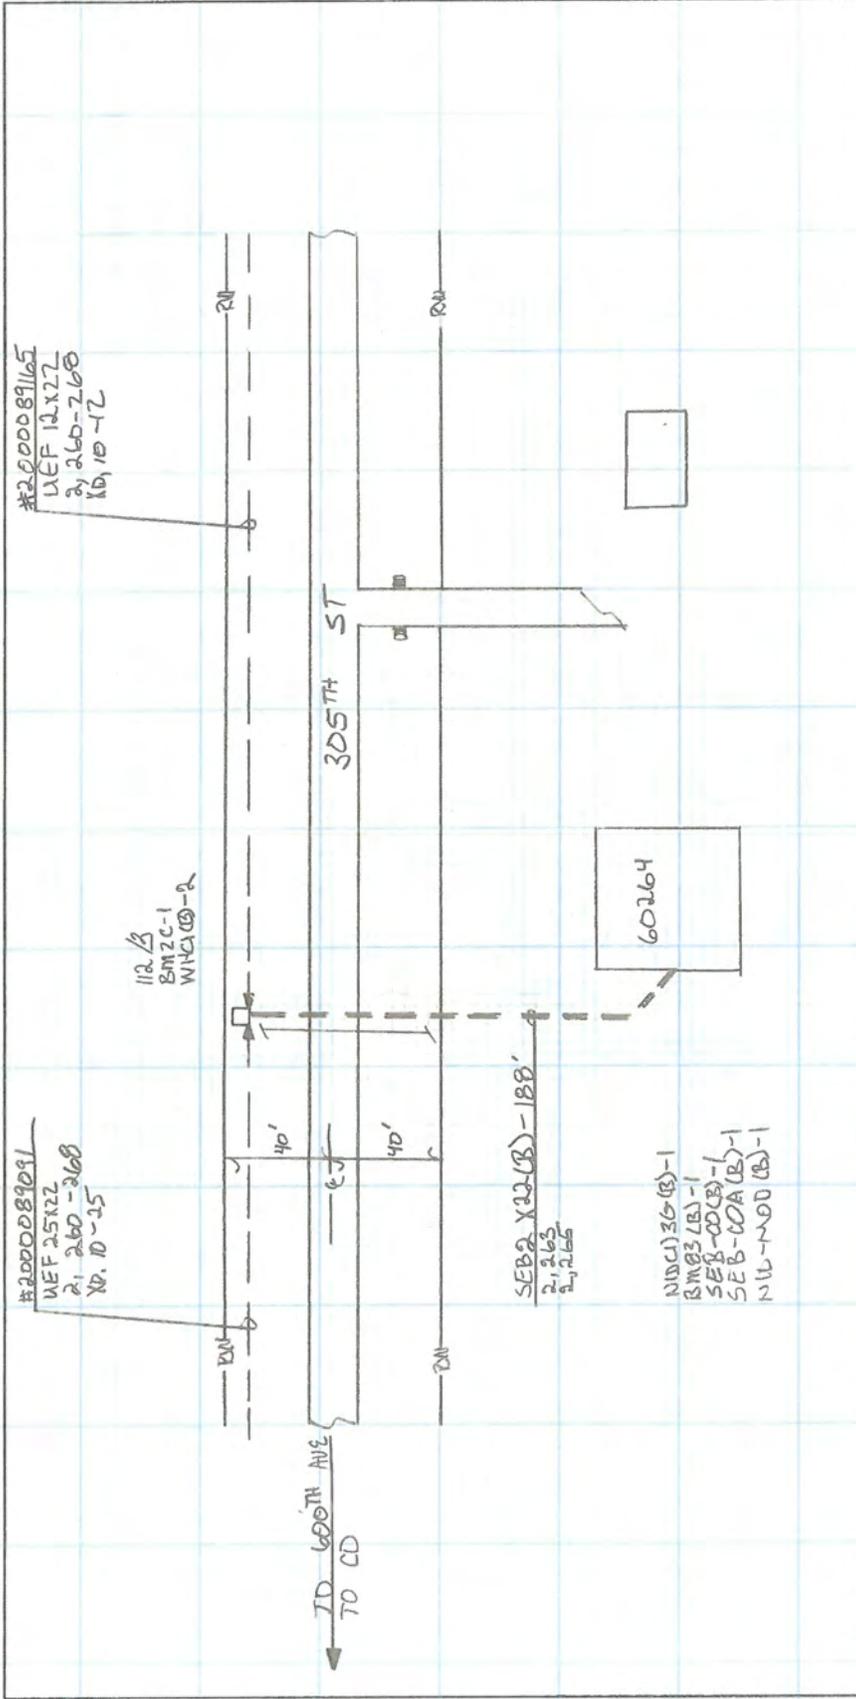

#2000089091  
 UEF 25X22  
 2, 260-268  
 N. 10-25

#2000089165  

112 B  
 BM 2C-1  
 W14C10-2

SEB2 X22(B)-188'  
 2, 263  
 2, 265

N10C136(B)-1  
 B1M83(B)-1  
 SEB-00(B)-1  
 SEB-00A(B)-1  
 N14-N10(B)-1


NOTE AREA:  
 STORY COUNTY  
 UNION TWP SEC. 14  
 BORE ROAD AT A MIN  
 36" DEPTH DITCH BOTTOM  
 TO DITCH BOTTOM

**windstream.**

ALL KNOWN OBSTRUCTIONS HAVE BEEN SHOWN. THOSE AND OTHERS, IF ANY, ARE THE RESPONSIBILITY OF THE CONTRACTOR OR THE WINDSTREAM CREW.

CALL ONE-CALL: 1-800-292-8989  
 48 HOURS PRIOR TO CONSTRUCTION.

EXCH #:	EXCH NAME: CAMBERKING-5	REM. CODE:
WOP: 13300095700003	TAX DIST:	
TITLE: DN CWB	REPLACE DEF APRD	60264 2027
TWP: 92 N	RNG: 23 W	SEC: 14
DATE: 11-22-20	REV. DATE:	SCALE: NONE
FILE:	DRWN: JTLW	ENGR: JTLW
	APPRVD:	PRINT #:
		1071

## STORY COUNTY UTILITY PERMIT

Date 2/14/20

To the Board of Supervisors, Story County, Iowa:

The Windstream Iowa Communications, LLC Company, incorporated under the laws of Iowa, with its principal place of business at 4001 N. Rodney Parham Road, Little Rock, AR 72212, does hereby make application requesting permission to occupy certain portions of public right-of-way and that the County Engineer be directed to establish the location of lines of transmission of fiber on secondary route 295th Street, from 295th Street to 653rd Ave, a distance of 0.27 miles.

Agreements: The utility company, corporation, applicant, permittee, or licensee, (hereinafter referred to as the permittee) agrees that the following stipulations shall govern under this permit.

1. The Permittee will file a plat setting out the location of proposed line on the secondary route and that the description of the proposed installation including type, height, and spacing of poles, maximum voltage, lengths of cross arms, minimum clearance and number of wires, type, size and capacity of underground cables, conduits, tile lines, and pipe lines, maximum working pressures for pipe lines carrying gas or flammable petroleum products are described as follows:
2. The installation shall meet the requirements of county, state, and federal laws, franchise rules, and of the Iowa State Commerce Commission Regulations and Directives, Utilities Division, the Iowa State Department of Health, and any other laws or regulations applicable.
3. The Permittee shall be fully responsible for any future adjustments of its facilities within the established highway right-of-way caused by highway construction or maintenance operations.
4. Story County assumes no responsibility for damages to the Permittee's property occasioned by any construction or maintenance operations on said highways.
5. The Permittee shall take all reasonable precautions during the construction and maintenance of said installation to protect and safeguard the lives and property of the traveling public and adjacent property owners.
6. The Permittee, and its contractors, shall carry on the construction or repair of the accommodated utility with serious regard to the safety of the public. Traffic protection shall be in accordance with Part VI of the current Iowa Department of Transportation Manual on Uniform Control Devices for Streets and Highways.
7. The Permittee shall be responsible for any damage resulting to said highways because of the construction operation, or maintenance of said utility, and shall reimburse Story County for any expenditure the County may have to make on said highways because of said permittee's utility having been constructed, operated, and maintained thereon.
8. The Permittee shall indemnify and save harmless Story County from any and all causes of action, suits at law or in equity, or losses, damages, claims, or demands, and from any and all

liability and expense of whatsoever nature for, on account of or due to the acts or omissions of said Permittee's officers, members, agents, representatives, contractors, employees or assigns arising out of or in connection with its (or their) use or occupancy of the public highway under this permit.

9. Noncompliance with any of the terms of permit, or agreement, may be considered cause for shut down of utility construction operations, or revocation of the permit.

10. The following special requirements, if applicable, shall apply to this permit:

Whenever the route of the proposed cable line runs along a paved secondary highway, the location of said cable shall be constructed on top of the road shoulder so as to be within approximately two-feet of the pavement edge.

Whenever the route of the proposed cable line runs along a dirt or gravel surfaced highway, the location of said cable shall be constructed on top of the road surface and as near possible to the shoulder line

Whenever a cross road culvert or bridge is encountered along the route of the proposed cable lines, said cable shall be constructed around the ends of said cross road culvert or bridge even though this looping is not designated on the situation plans attached hereto.

The crossing of the cable line from one side of the highway to the other shall be accomplished at a near right angle rather than diagonally so as to disturb the roadbed of the traveled way as little as possible.

Whenever the route of the proposed cable line is to cross a paved highway, such crossing shall be in a bored hole rather than open cut trench.

Date 02/12/20

Windstream Iowa Communications, LLC  
Name of Company (Applicant - Permittee)

Deanna L. Phillips Deanna L. Phillips 501-748-9471  
by Phone no.

Recommended for Approval:

Date 2-13-20

Jane M. M... 515-382-7355  
County Engineer Phone no.


Approved:

Date 2-25-2020

Mudak... 515-382-7355  
Chair, Board of Supervisors  
Story County, Iowa

Three (3) copies of this form will be required for each installation. A plat shall be attached to each copy submitted.

# VICINITY MAP

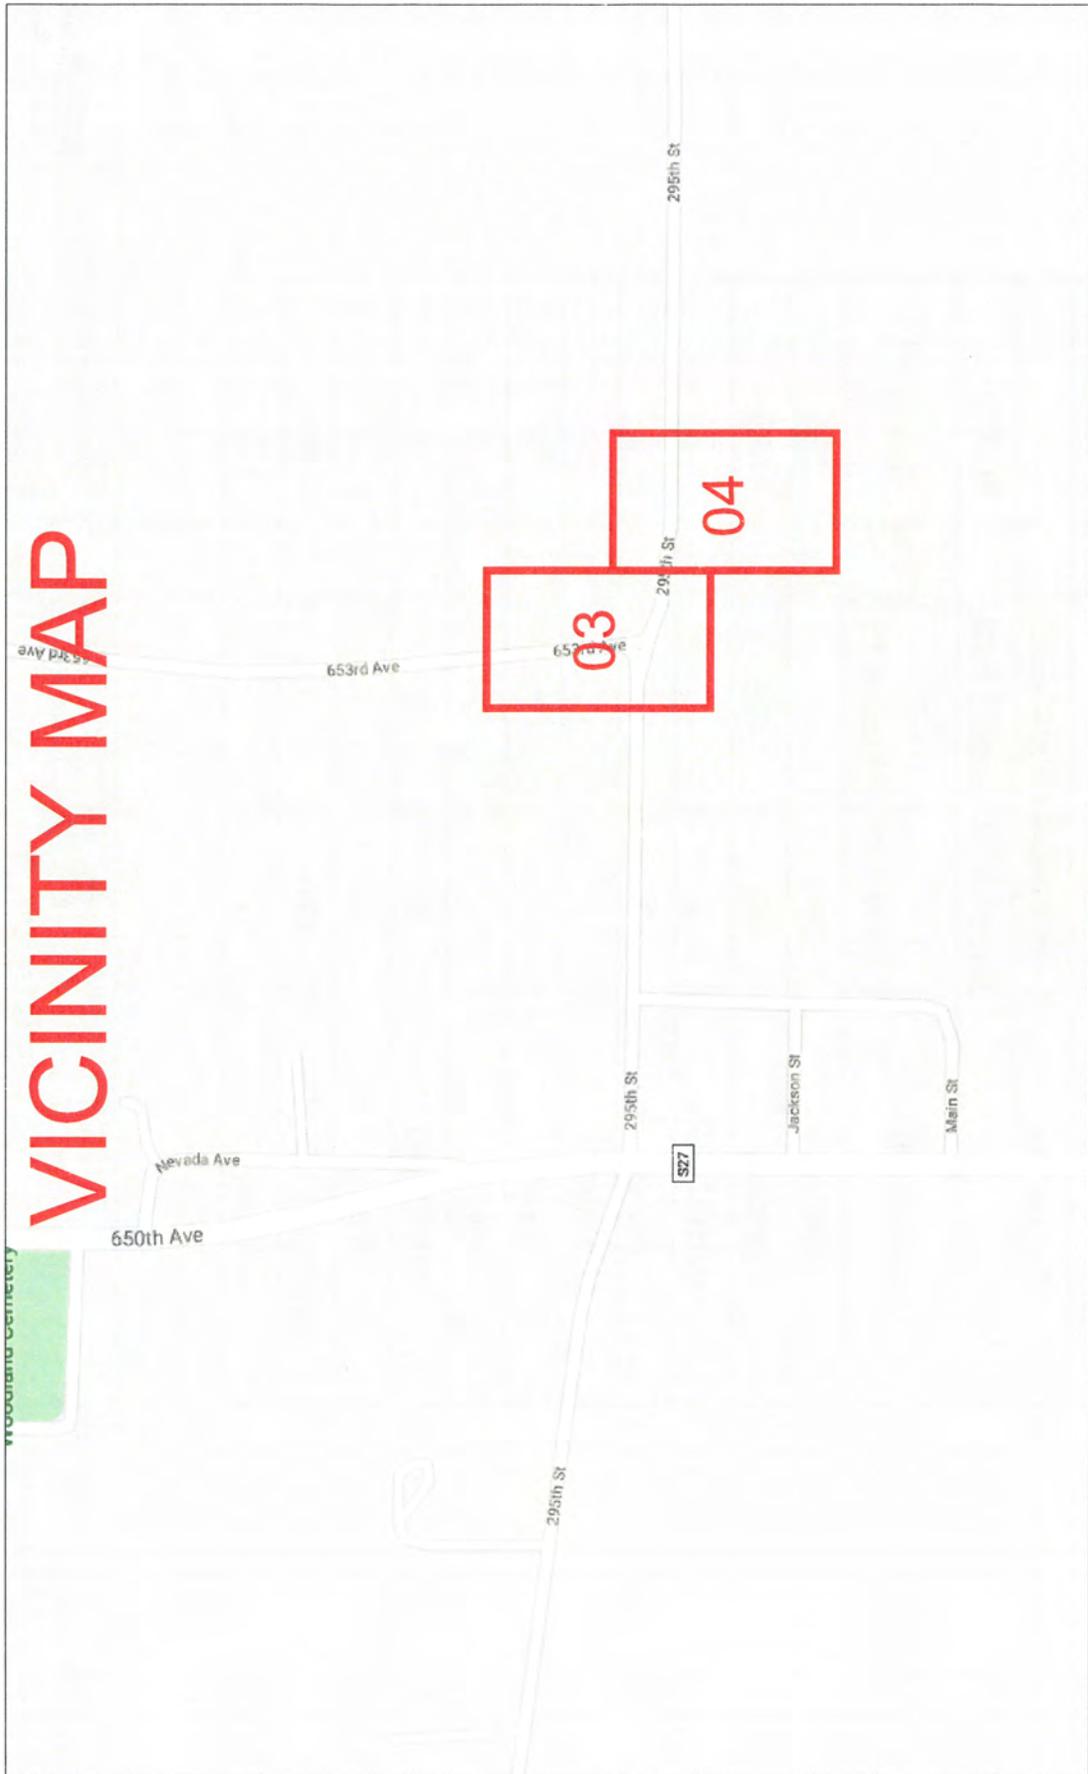

PROJECT: 71392230  
 PROJECT TITLE: CAPW0419 - EMR06055  
 EXCHANGE: MXVLAJXP  
 SHEET: VICINITY MAP DATE: 01/10/2020

ENGINEER: WINDSTREAM - CHRIS COOK  
 FIELD ENGINEER: PEARCE SERVICES TROY OZBUN  
 DRAWN BY: PEARCE SERVICES SALEEM ALBI



ADDRESS:- 295TH ST, MAXWELL, IA 50161  
 STORY COUNTY, IA  
 PERMIT REQUIRED - COUNTY  
 LOCATE ALL FACILITIES PRIOR TO DIGGING  
 IA - IOWA ONE CALL - 811 - 1-800-292-8989  
 SCALE: NTS

EXCHANGE NAME:	MXWLIAXP	W.O. # 713392230	
W.O.TITLE	CAFW0419 - EWR06055		
	SHEET # 03	SHEET # 04	TOTAL
UNIT CODE:	EST. QUANTITY	EST. QUANTITY	EST. QUANTITY
BFO48	760		760
BFO48I	60	405	465
WHO1(B)	2		2
BM2C	1		1
HOMW(B)	2		2
BDO		2	2
BM2		2	2
HBFO(48)	1	1	2
BM53F	1	1	2
BM60(1)(1.25)PF	60		60
XXHBFO	1		1

ADDRESS:- 295TH ST, MAXWELL, IA 50161  
 STORY COUNTY, IA  
 PERMIT REQUIRED - COUNTY  
 LOCATE ALL FACILITIES PRIOR TO DIGGING  
 IA - IOWA ONE CALL - 811 - 1-800-292-8989


SCALE: NTS



ENGINEER: WINDSTREAM -  
 CHRIS COOK  
 FIELD ENGINEER: PEARCE SERVICES  
 TROY OZBUN  
 DRAWN BY: PEARCE SERVICES  
 SALEEM ALBI

PROJECT: 713392230  
 PROJECT TITLE: CAFW0419 - EWR06055  
 EXCHANGE: MXWLIAXP  
 SHEET: 2 OF 4  
 DATE: 01/10/2020



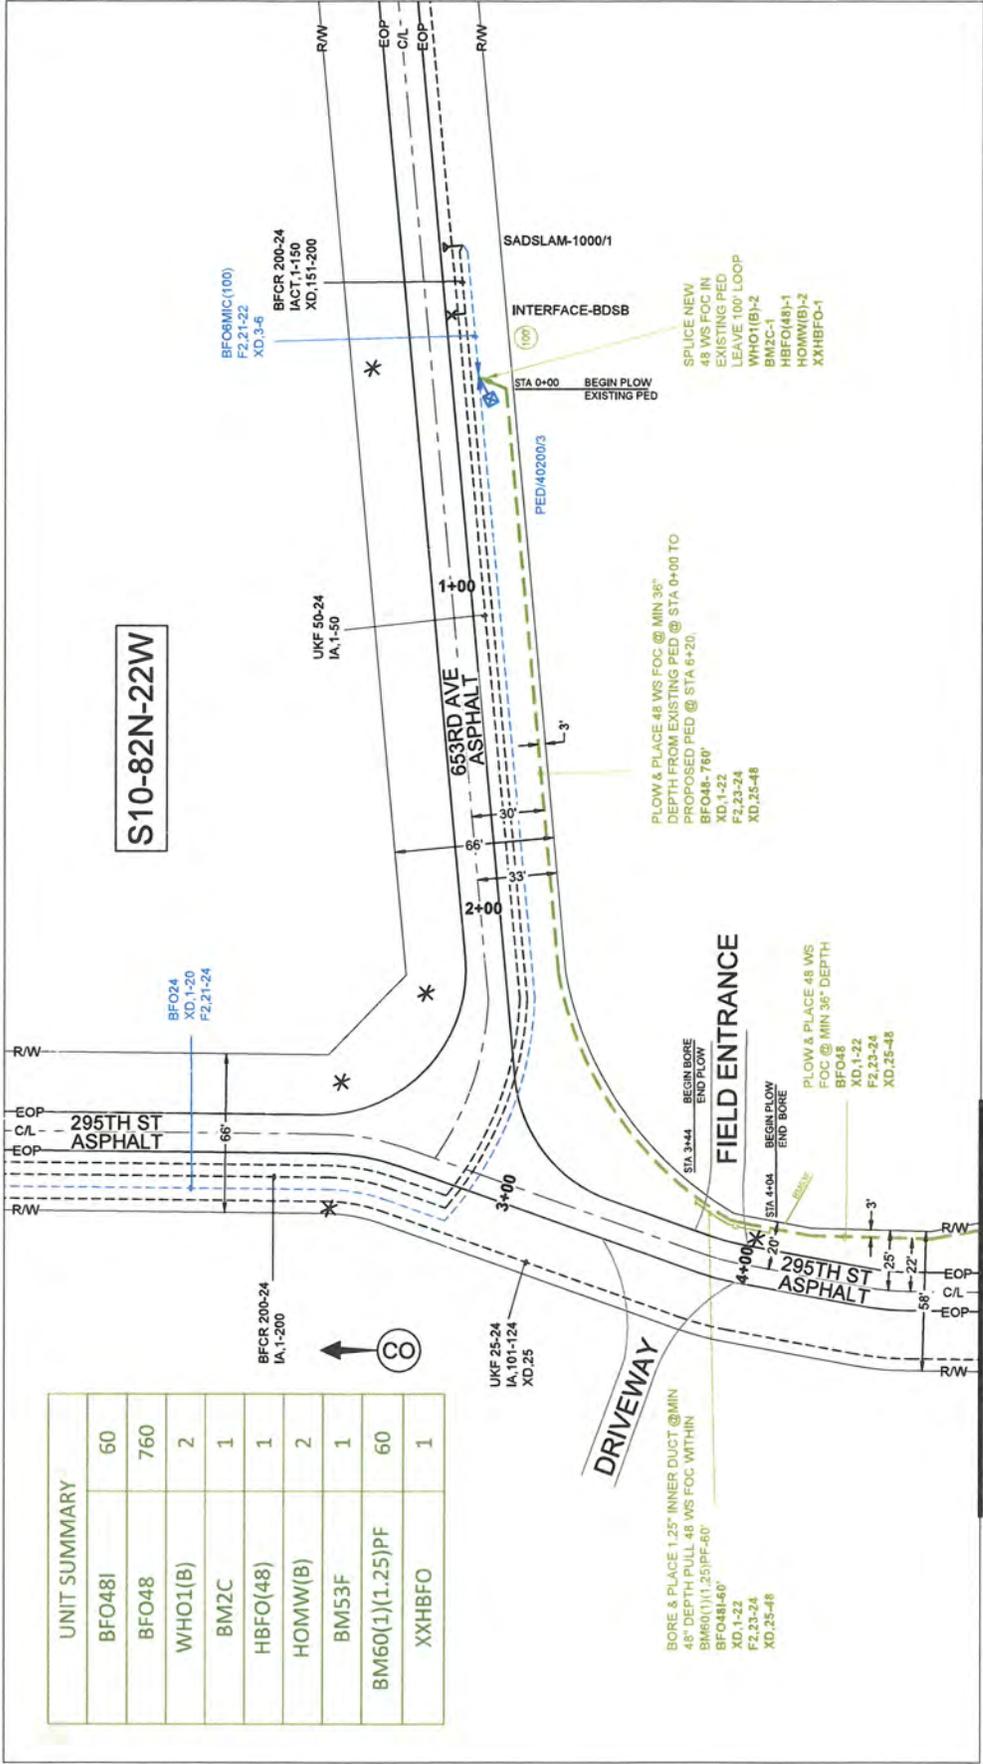

**S10-82N-22W**

UNIT SUMMARY	
BFO48I	60
BFO48	760
WHO1(B)	2
BM2C	1
HBFO(48)	1
HOMW(B)	2
BM53F	1
BM60(1)(1.25)PF	60
XXHBFO	1

MATCHLINE - SEE SHEET 04

**ADDRESS:- 295TH ST, MAXWELL, IA 50161**  
**STORY COUNTY,IA**  
**PERMIT REQUIRED - COUNTY**  
**LOCATE ALL FACILITIES PRIOR TO DIGGING**  
**IA - IOWA ONE CALL - 811 - 1-800-292-8989**

**SCALE: 1:50**

**windstream**  
communications


**PEARCE SERVICES**

ENGINEER: **WINDSTREAM - CHRIS COOK**  
 FIELD ENGINEER: **PEARCE SERVICES TROY OZBUN**  
 DRAWN BY: **PEARCE SERVICES SALEEM ALBI**

PROJECT: 71382230  
 PROJECT TITLE: CAFW0419 - EWR06055  
 EXCHANGE: MKVLIAXP  
 SHEET: 3 OF 4  
 DATE: 01/10/2020



MATCHLINE - SEE SHEET 03

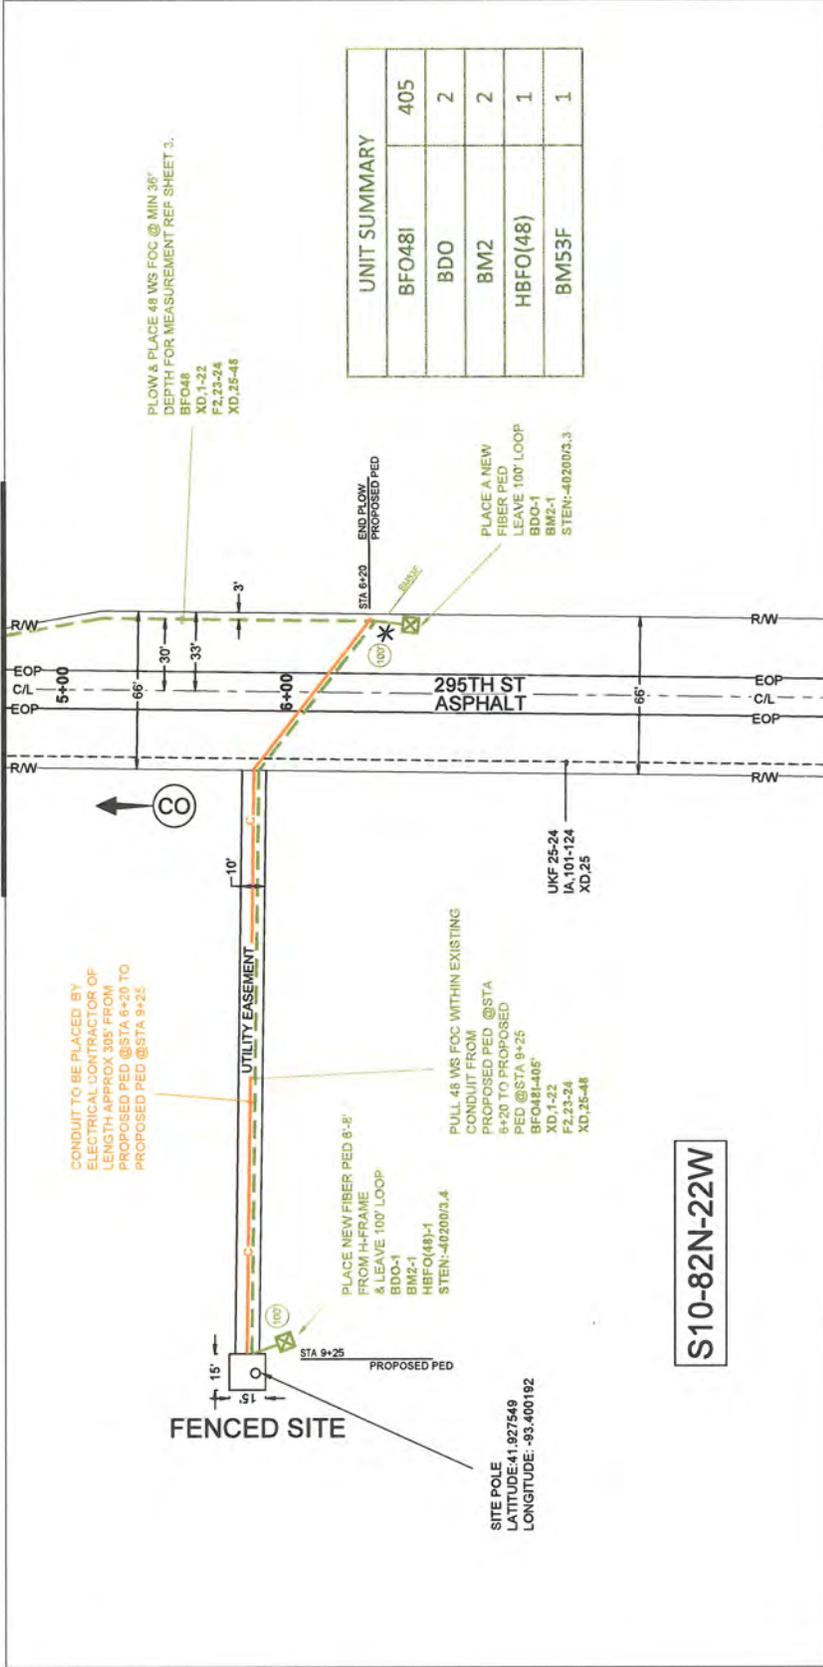

UNIT SUMMARY	
BFO481	405
BDO	2
BM2	2
HBFO(48)	1
BM53F	1

CONDUIT TO BE REPLACED BY ELECTRICAL CONTRACTOR OF LENGTH APPROX 305' FROM PROPOSED PED @STA 6+20 TO PROPOSED PED @STA 9+25

UTILITY EASEMENT

PLACE NEW FIBER PED 6'-8" FROM H-FRAME & LEAVE 100' LOOP BDO-1 BM2-1 HBFO(48)-1 STEN:-40200/3.4

PULL 48 WS FOC WITHIN EXISTING CONDUIT FROM PROPOSED PED @STA 6+20 TO PROPOSED PED @STA 9+25 BFO(48)-1 XD.1-22 F2.23-24 XD.25-48

SITE POLE  
 LATITUDE: 41.927549  
 LONGITUDE: -93.400192

S10-82N-22W

PLOW & PLACE 48 WS FOC @ MIN 36" DEPTH FOR MEASUREMENT REF SHEET 3.  
 BFO48  
 XD.1-22  
 F2.23-24  
 XD.25-48

 PLACE A NEW FIBER PED LEAVE 100' LOOP BDO-1 BM2-1 STEN:-40200/3.3

ADDRESS:- 295TH ST, MAXWELL, IA 50161  
 STORY COUNTY, IA  
 PERMIT REQUIRED - COUNTY  
 LOCATE ALL FACILITIES PRIOR TO DIGGING  
 IA - IOWA ONE CALL - 811 - 1-800-292-8989



ENGINEER: WINDSTREAM - CHRIS COOK  
 FIELD ENGINEER: PEARCE SERVICES TROY OZBUN  
 DRAWN BY: PEARCE SERVICES SALEEM ALBI

PROJECT: 71339230  
 PROJECT TITLE: CAPW0419 - EWR06055  
 EXCHANGE: MXWLIAXP  
 SHEET: 4 OF 4  
 DATE: 01/10/2020



SCALE: 1:50

## STORY COUNTY UTILITY PERMIT

Date 2/14/20

To the Board of Supervisors, Story County, Iowa:

The Windstream Iowa Communications, LLC Company, incorporated under the laws of Iowa, authorize to do business within the State of Iowa, with its principal place of business at 4001 N. Rodney Parham Road, Little Rock, AR, does hereby make application requesting permission to occupy certain portions of public right-of-way and that the County Engineer be directed to establish the location of lines of transmission of plow and bore cable on secondary route 585th Ave, from 33505 585th Ave to Hwy 210, a distance of 0.56 miles.

Agreements: The utility company, corporation, applicant, permittee, or licensee, (hereinafter referred to as the permittee) agrees that the following stipulations shall govern under this permit.

1. The Permittee will file a plat setting out the location of proposed line on the secondary route and that the description of the proposed installation including type, height, and spacing of poles, maximum voltage, lengths of cross arms, minimum clearance and number of wires, type, size and capacity of underground cables, conduits, tile lines, and pipe lines, maximum working pressures for pipe lines carrying gas or flammable petroleum products are described as follows:
2. The installation shall meet the requirements of county, state, and federal laws, franchise rules, and of the Iowa State Commerce Commission Regulations and Directives, Utilities Division, the Iowa State Department of Health, and any other laws or regulations applicable.
3. The Permittee shall be fully responsible for any future adjustments of its facilities within the established highway right-of-way caused by highway construction or maintenance operations.
4. Story County assumes no responsibility for damages to the Permittee's property occasioned by any construction or maintenance operations on said highways.
5. The Permittee shall take all reasonable precautions during the construction and maintenance of said installation to protect and safeguard the lives and property of the traveling public and adjacent property owners.
6. The Permittee, and its contractors, shall carry on the construction or repair of the accommodated utility with serious regard to the safety of the public. Traffic protection shall be in accordance with Part VI of the current Iowa Department of Transportation Manual on Uniform Control Devices for Streets and Highways.
7. The Permittee shall be responsible for any damage resulting to said highways because of the construction operation, or maintenance of said utility, and shall reimburse Story County for any expenditure the County may have to make on said highways because of said permittee's utility having been constructed, operated, and maintained thereon.
8. The Permittee shall indemnify and save harmless Story County from any and all causes of action, suits at law or in equity, or losses, damages, claims, or demands, and from any and all

liability and expense of whatsoever nature for, on account of or due to the acts or omissions of said Permittee's officers, members, agents, representatives, contractors, employees or assigns arising out of or in connection with its (or their) use or occupancy of the public highway under this permit.

9. Noncompliance with any of the terms of permit, or agreement, may be considered cause for shut down of utility construction operations, or revocation of the permit.

10. The following special requirements, if applicable, shall apply to this permit:

Whenever the route of the proposed cable line runs along a paved secondary highway, the location of said cable shall be constructed on top of the road shoulder so as to be within approximately two-feet of the pavement edge.

Whenever the route of the proposed cable line runs along a dirt or gravel surfaced highway, the location of said cable shall be constructed on top of the road surface and as near possible to the shoulder line

Whenever a cross road culvert or bridge is encountered along the route of the proposed cable lines, said cable shall be constructed around the ends of said cross road culvert or bridge even though this looping is not designated on the situation plans attached hereto.

The crossing of the cable line from one side of the highway to the other shall be accomplished at a near right angle rather than diagonally so as to disturb the roadbed of the traveled way as little as possible.

Whenever the route of the proposed cable line is to cross a paved highway, such crossing shall be in a bored hole rather than open cut trench.

Date 02/12/2020

Windstream Iowa Communications, LLC  
Name of Company (Applicant - Permittee)

Deanna L. Phillips Deanna L. Phillips 501-748-9471  
by Phone no.

Recommended for Approval:

Date 2-13-20

Dan Mon 515-382-7355  
County Engineer Phone no.

Approved:

Date 2-25-2020

Phillips  
Chair, Board of Supervisors  
Story County, Iowa


**Three (3) copies of this form will be required for each installation. A plat shall be attached to each copy submitted.**

Farm-to-Market Road System Map


**STORY COUNTY**  
IOWA




12-4-2011

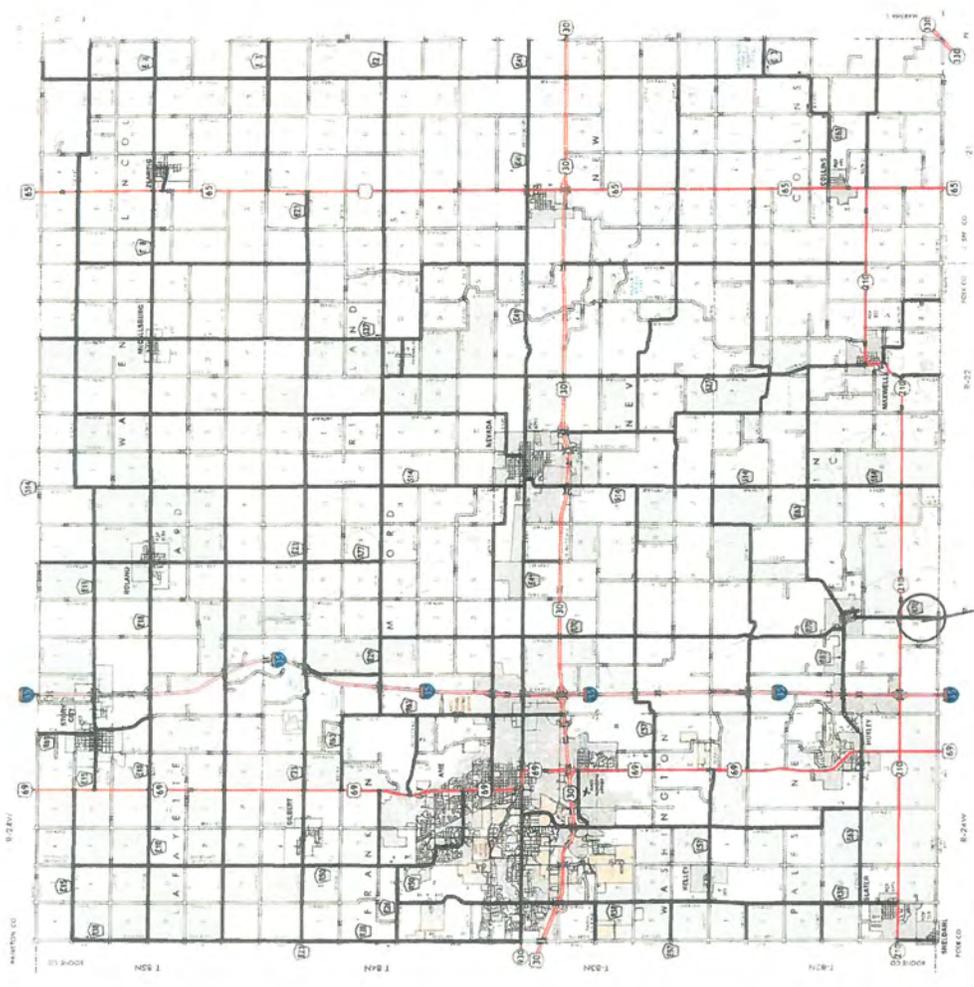

WORK AREA  
713309066-00003 03

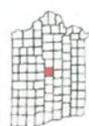

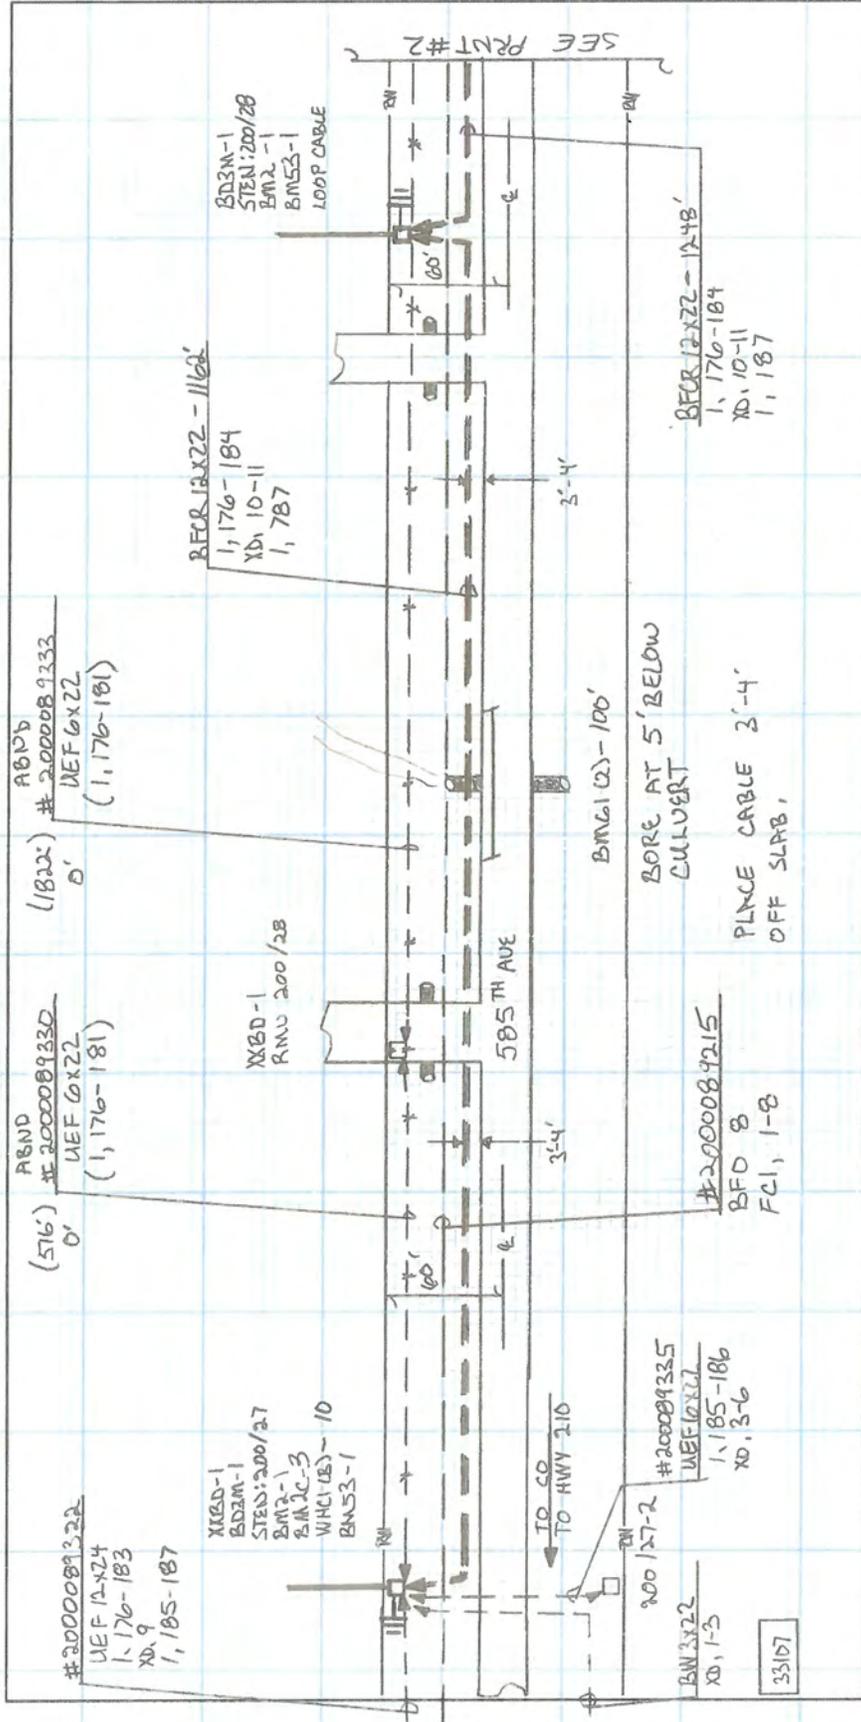

CALL ONE-CALL: 1-800-292-8989  
 48 HOURS PRIOR TO CONSTRUCTION.

EXCH # 713309066-00003 REM CODE  
 WORK CUN CABLE REFERENCE CABLE TAX DIST  
 TITLE CUN CABLE REFERENCE CABLE 200/27-29  
 TWP 23 W 23 V SEC 32  
 DATE 1-23-20 REV DATE DRWN ENGR APPRVD PRINT #  
 FILE: JLM JTW 1 OF 2

windstream.

ALL KNOWN OBSTRUCTIONS HAVE BEEN SHOWN. THOSE AND OTHERS, IF ANY, ARE THE RESPONSIBILITY OF THE CONTRACTOR OR THE WINDSTREAM CREW.

NOTE AREA:  
 STORY COUNTY  
 UNION TWP SEC, 33  
 PLACE CABLE AT A  
 MINIMUM 30" DEPTH  
 AT 3' TO 4' FROM SLAB.

UNIT CODE	ESTIMATED QUANTITY	AS BUILT QUANTITY
XBD-1	2	
BD2M-1	2	
STEN-200/27	2	
BMS3-1	2	
WMC10-3	2	
WMC10-10	2	
BMS3-1	2	
DEF 6x22	240	
BMS3-1	200	



## STORY COUNTY UTILITY PERMIT

Date 2/20/20

To the Board of Supervisors, Story County, Iowa:

The Minerva Valley Tel. Co. Company, incorporated under the laws of authorize to do business within the State of Iowa, with its principal place of business at Zearing, Iowa, does hereby make application requesting permission to occupy certain portions of public right-of-way and that the County Engineer be directed to establish the location of lines of transmission of Fiber Optic Cable on secondary route Varies See Attached, from See Attached to See Attached, a distance of See Attached miles.

Agreements: The utility company, corporation, applicant, permittee, or licensee, (hereinafter referred to as the permittee) agrees that the following stipulations shall govern under this permit.

1. The Permittee will file a plat setting out the location of proposed line on the secondary route and that the description of the proposed installation including type, height, and spacing of poles, maximum voltage, lengths of cross arms, minimum clearance and number of wires, type, size and capacity of underground cables, conduits, tile lines, and pipe lines, maximum working pressures for pipe lines carrying gas or flammable petroleum products are described as follows:
2. The installation shall meet the requirements of county, state, and federal laws, franchise rules, and of the Iowa State Commerce Commission Regulations and Directives, Utilities Division, the Iowa State Department of Health, and any other laws or regulations applicable.
3. The Permittee shall be fully responsible for any future adjustments of its facilities within the established highway right-of-way caused by highway construction or maintenance operations.
4. Story County assumes no responsibility for damages to the Permittee's property occasioned by any construction or maintenance operations on said highways.
5. The Permittee shall take all reasonable precautions during the construction and maintenance of said installation to protect and safeguard the lives and property of the traveling public and adjacent property owners.
6. The Permittee, and its contractors, shall carry on the construction or repair of the accommodated utility with serious regard to the safety of the public. Traffic protection shall be in accordance with Part VI of the current Iowa Department of Transportation Manual on Uniform Control Devices for Streets and Highways.
7. The Permittee shall be responsible for any damage resulting to said highways because of the construction operation, or maintenance of said utility, and shall reimburse Story County for any expenditure the County may have to make on said highways because of said permittee's utility having been constructed, operated, and maintained thereon.
8. The Permittee shall indemnify and save harmless Story County from any and all causes of action, suits at law or in equity, or losses, damages, claims, or demands, and from any and all

liability and expense of whatsoever nature for, on account of or due to the acts or omissions of said Permittee's officers, members, agents, representatives, contractors, employees or assigns arising out of or in connection with its (or their) use or occupancy of the public highway under this permit.

9. Noncompliance with any of the terms of permit, or agreement, may be considered cause for shut down of utility construction operations, or revocation of the permit.

10. The following special requirements, if applicable, shall apply to this permit:

Whenever the route of the proposed cable line runs along a paved secondary highway, the location of said cable shall be constructed on top of the road shoulder so as to be within approximately two-feet of the pavement edge.

Whenever the route of the proposed cable line runs along a dirt or gravel surfaced highway, the location of said cable shall be constructed on top of the road surface and as near possible to the shoulder line

Whenever a cross road culvert or bridge is encountered along the route of the proposed cable lines, said cable shall be constructed around the ends of said cross road culvert or bridge even though this looping is not designated on the situation plans attached hereto.

The crossing of the cable line from one side of the highway to the other shall be accomplished at a near right angle rather than diagonally so as to disturb the roadbed of the traveled way as little as possible.

Whenever the route of the proposed cable line is to cross a paved highway, such crossing shall be in a bored hole rather than open cut trench.

Date 2-10-2020

Minerva Valley Tel. Co  
Name of Company (Applicant - Permittee)

by  (641) - 487 - 7399  
Phone no.


Recommended for Approval:

Date 2-20-20


 515-382-7355  
County Engineer Phone no.

Approved:

Date 2-25-2020

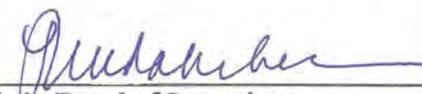
  
Chair, Board of Supervisors  
Story County, Iowa

Three (3) copies of this form will be required for each installation. A plat shall be attached to each copy submitted.

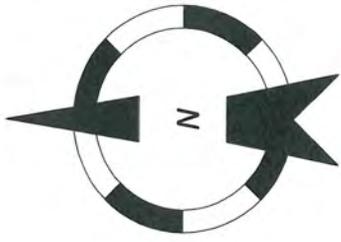

Zearing, Iowa  
**Proposed Fiber Route**  
 Existing Fiber Route

State: Iowa  
 County: Story  
 Range: 21 W  
 Twp: 85 N

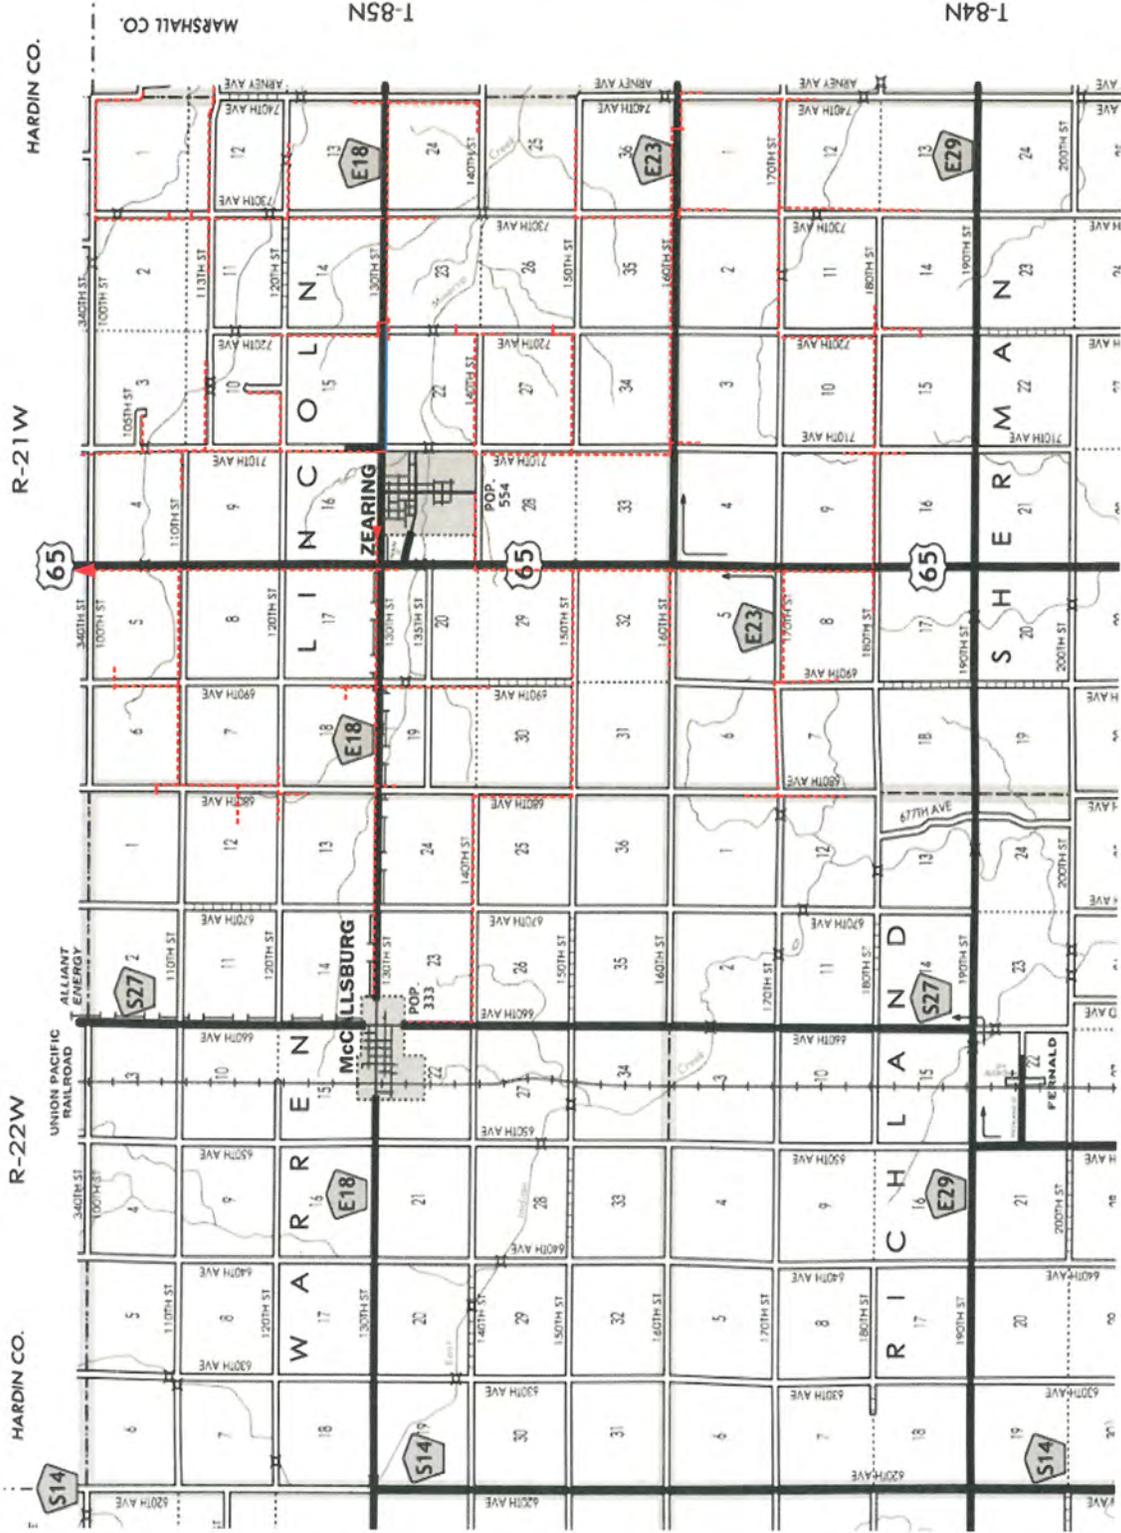

HARDIN CO. R-22W R-21W R-18W MARSHALL CO. T-85N T-84N

## STORY COUNTY UTILITY PERMIT

Date 2/20/20

To the Board of Supervisors, Story County, Iowa:

The Complete Communications Services Corp Company, incorporated under the laws of Iowa, with its principal place of business at Stratford, IA, does hereby make application requesting permission to occupy certain portions of public right-of-way and that the County Engineer be directed to establish the location of lines of transmission of Buried Fiber Optic Cable on secondary route Varies, See Attached, from See Attached Sheets to See Attached Sheets, a distance of See Attached Sheets miles.

Agreements: The utility company, corporation, applicant, permittee, or licensee, (hereinafter referred to as the permittee) agrees that the following stipulations shall govern under this permit.

1. The Permittee will file a plat setting out the location of proposed line on the secondary route and that the description of the proposed installation including type, height, and spacing of poles, maximum voltage, lengths of cross arms, minimum clearance and number of wires, type, size and capacity of underground cables, conduits, tile lines, and pipe lines, maximum working pressures for pipe lines carrying gas or flammable petroleum products are described as follows:
2. The installation shall meet the requirements of county, state, and federal laws, franchise rules, and of the Iowa State Commerce Commission Regulations and Directives, Utilities Division, the Iowa State Department of Health, and any other laws or regulations applicable.
3. The Permittee shall be fully responsible for any future adjustments of its facilities within the established highway right-of-way caused by highway construction or maintenance operations.
4. Story County assumes no responsibility for damages to the Permittee's property occasioned by any construction or maintenance operations on said highways.
5. The Permittee shall take all reasonable precautions during the construction and maintenance of said installation to protect and safeguard the lives and property of the traveling public and adjacent property owners.
6. The Permittee, and its contractors, shall carry on the construction or repair of the accommodated utility with serious regard to the safety of the public. Traffic protection shall be in accordance with Part VI of the current Iowa Department of Transportation Manual on Uniform Control Devices for Streets and Highways.
7. The Permittee shall be responsible for any damage resulting to said highways because of the construction operation, or maintenance of said utility, and shall reimburse Story County for any expenditure the County may have to make on said highways because of said permittee's utility having been constructed, operated, and maintained thereon.
8. The Permittee shall indemnify and save harmless Story County from any and all causes of action, suits at law or in equity, or losses, damages, claims, or demands, and from any and all

liability and expense of whatsoever nature for, on account of or due to the acts or omissions of said Permittee's officers, members, agents, representatives, contractors, employees or assigns arising out of or in connection with its (or their) use or occupancy of the public highway under this permit.

9. Noncompliance with any of the terms of permit, or agreement, may be considered cause for shut down of utility construction operations, or revocation of the permit.

10. The following special requirements, if applicable, shall apply to this permit:

Whenever the route of the proposed cable line runs along a paved secondary highway, the location of said cable shall be constructed on top of the road shoulder so as to be within approximately two-feet of the pavement edge.

Whenever the route of the proposed cable line runs along a dirt or gravel surfaced highway, the location of said cable shall be constructed on top of the road surface and as near possible to the shoulder line


Whenever a cross road culvert or bridge is encountered along the route of the proposed cable lines, said cable shall be constructed around the ends of said cross road culvert or bridge even though this looping is not designated on the situation plans attached hereto.

The crossing of the cable line from one side of the highway to the other shall be accomplished at a near right angle rather than diagonally so as to disturb the roadbed of the traveled way as little as possible.

Whenever the route of the proposed cable line is to cross a paved highway, such crossing shall be in a bored hole rather than open cut trench.


Date 2-13-20

Complete Communications Services Corp.  
Name of Company (Applicant - Permittee)

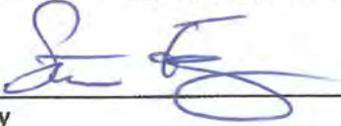  
by \_\_\_\_\_ Phone no. 515-838-2390


Recommended for Approval:

Date 2-20-20

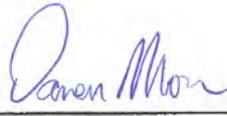
  
County Engineer Phone no. 515-382-7355

Approved:

Date 2-25-2020

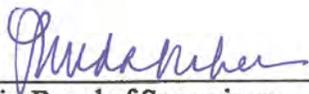  
Chair, Board of Supervisors  
Story County, Iowa

Three (3) copies of this form will be required for each installation. A plat shall be attached to each copy submitted.

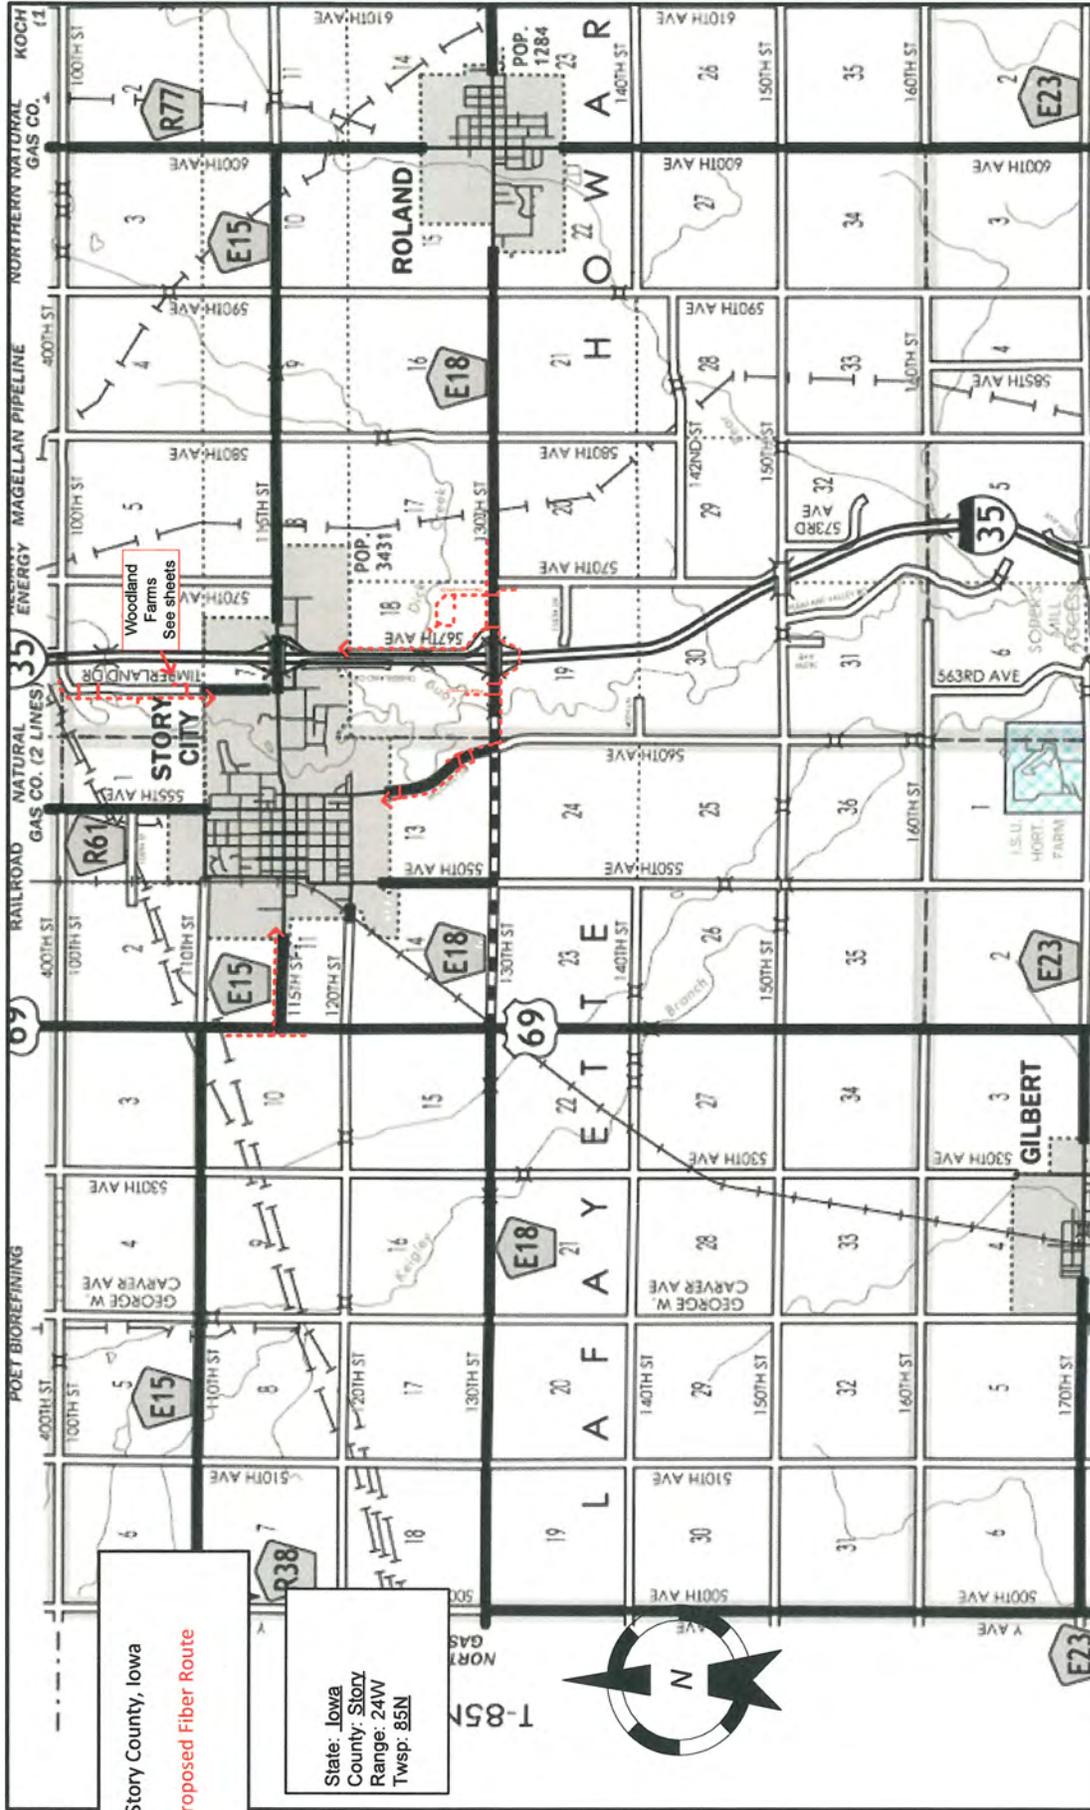

Story County, Iowa  
 Proposed Fiber Route

State: Iowa  
 County: Story  
 Range: 24W  
 Twsp: 85N







Section 18

Section 13  
Range: 24W  
Twp: 85N



State: Iowa  
County: Story  
Range: 23W  
Twp: 85N

**As Built**  
**Complete Communications**  
 Name: E-08  
 WO: VPS\_STORY\_19  
 Exch: Story City  
 Route: B  
 ROW: Public  
 Staked By: JAS Date: 07/10/19  
 Revised By: Date:  
 Ploved By: SEC Date:  
 Tabbed By: Date:  
  
 Drawing Not to Scale



Multiple Workorders  
 On sheet:  
 VPS\_STORY\_19-1  
 VPS\_STORY\_19-2  
 VPS\_STORY\_FUT-1

Existing BFO 12 will need to dug up for 100' & cut and swing 50' into both HH B/16 & B/17 to be spliced. This FF will feed the CO from here heading north into town. Some fibers will spliced back through to Roland. Work with Telco on timing and counts as this will be a hotcut.

Section 19


Section 24  
Range: 24W  
Twp: 85N

From	To	PType	Units	Feet	BM	HBFO	HO	ONT	Remarks
B/18	BDO5TSB				2(5/8)(8)	1	1	8	
B/18					60(1x1.25)(1x1.5)D	1150			
B/18	56330A	SEBO 4		210	83	1			Sub 56330A
B/18	56330B	SEBO 4		320	83	1			Sub 56330B
B/18	B/19	BFO 288R &		498	60(1.5)D	100	M	1	100' Coil
B/19		BFO 24RWD		588					100' Coil



State: Iowa  
 County: Story  
 Range: 23W  
 Twp: 85N


**As Staked**  
**Completa Communications**  
 Name: B-10  
 WO: VPS\_STORY\_19  
 Exch: Story City  
 Route: B  
 ROW: Public  
 Staked By: JAS Date: 01/06/12  
 Revised By: Date:  
 Plowed By: Date:  
 Tabbed By: Date:  
  
 Drawing Not to Scale

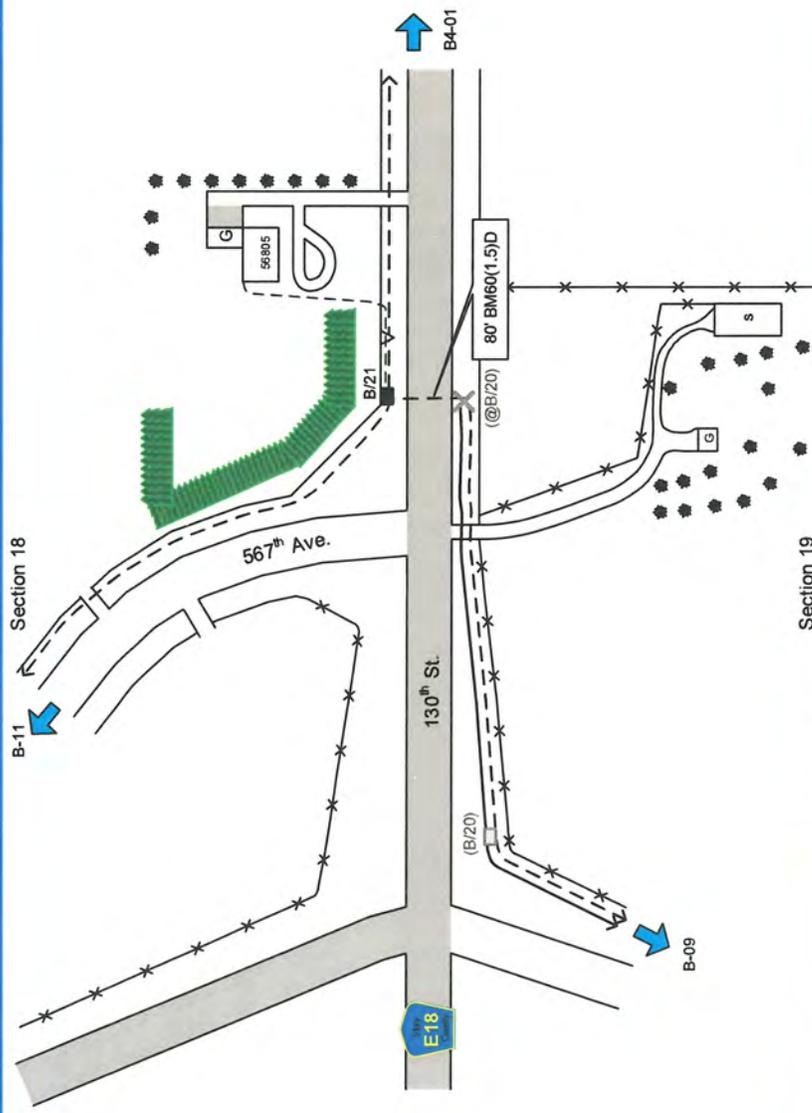

Section 18

Section 19

From	To	PType	Units	Feet	BM	HBFO	HO	ONT	Remarks
(X@B/20)	B/21	BHF(36x60x36)	BFO 288RW	0	2(5/8)(8)	1	1	1	
	B/21				55	1	12R	8	
	B/21				60(1.5)D	80			
B/21	56805		SEBO 4	410	83	1		HBSS	Sub 56805

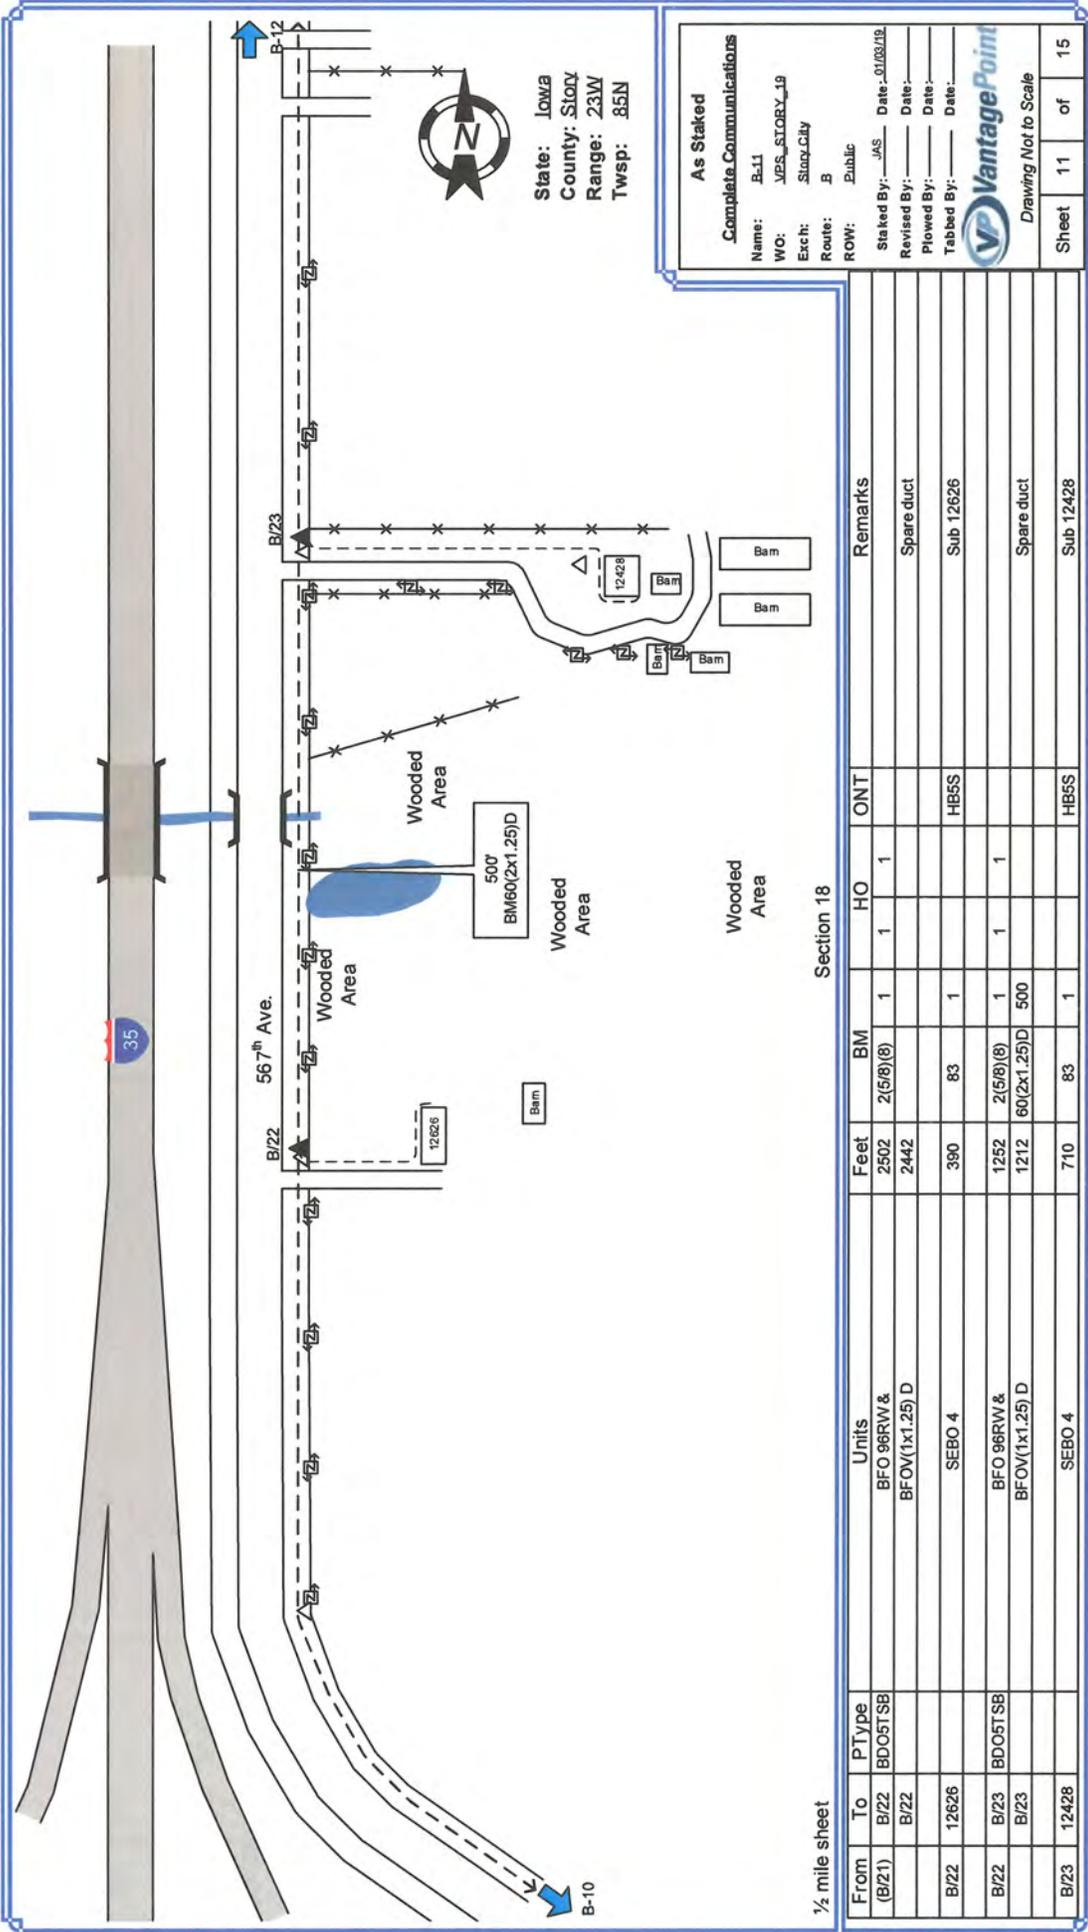

State: Iowa  
 County: Story  
 Range: 23W  
 Twp: 35N

**As Staked**

**Completa Communications**

Name: B-11  
 WO: JPS STORY 19  
 Exch: Story City  
 Route: B  
 ROW: Public

 Revised By: Date:  
 Plowed By: Date:  
 Tabbed By: Date:


**VantagePoint**  
 Drawing Not to Scale

Sheet 11 of 15

Section 18

1/2 mile sheet

From	To	P Type	Units	Feet	BM	HO	ONT	Remarks
B/21	B/22	BDO5TSB	BFO 96RW &	2502	2(5/8)(8)	1	1	
B/22	B/22		BFOV(1x1.25) D	2442				Spare duct
B/22	12626		SEBO 4	390	83			Sub 12626
B/22	B/23	BDO5TSB	BFO 96RW &	1252	2(5/8)(8)	1	1	
B/23	B/23		BFOV(1x1.25) D	1212	60(2x1.25)D	500		Spare duct
B/23	12428		SEBO 4	710	83	1		Sub 12428

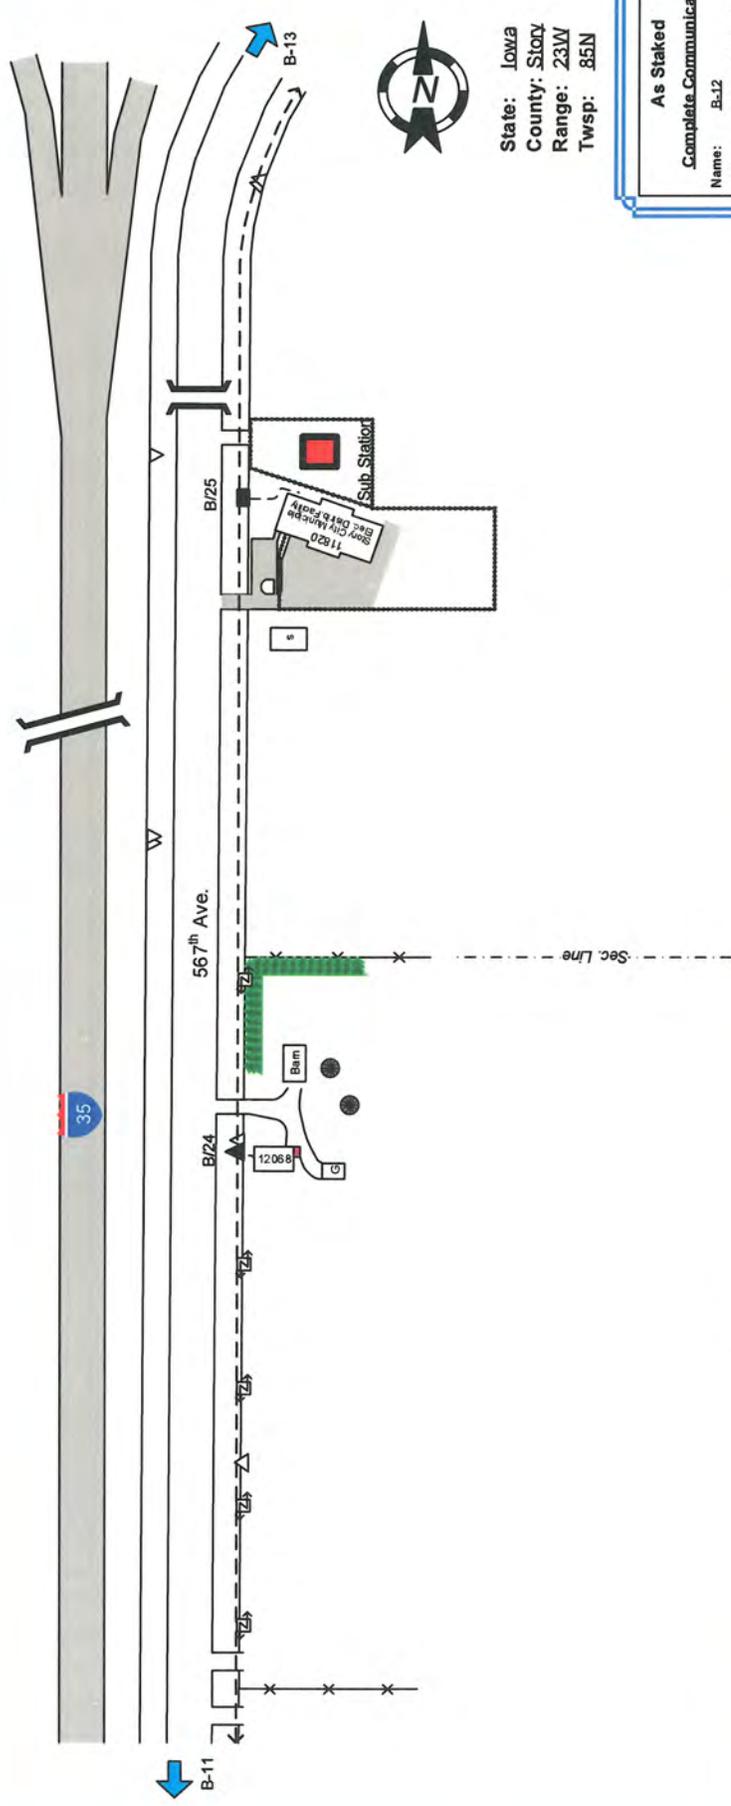

State: Iowa  
 County: Story  
 Range: 23W  
 Twsp: 85N



**As Staked**  
**Complete Communications**  
 Name: B-12  
 WO: VPS\_STORY\_19  
 Exch: Story City  
 Route: B  
 ROW: Public  
 Staked By: JAS Date: 01/03/19  
 Revised By: Date:  
 Plowed By: Date:  
 Tabbed By: Date:  
  
 Drawing Not to Scale  
 Sheet 12 of 15

Section 7

Section 18


1/4 mile sheet

From	To	PType	Units	Feet	BM	HBFO	HO	ONT	Remarks
B/23	B/24	BDO5TSB	BFO 96RW &	1954	2(5/8)Ø	1	1	1	
	B/24		BFOV(1x1.25) D	1914					Spare duct
B/24	12068		SEBO 4I	150	83				HB3S
	12068		SEBOV(1x.75)	130					
B/24	B/25	BHF(30x48x36)	BFO 96RW &	1278	2(5/8)Ø	1	M	1	100' Coil
	B/25		BFOV(1x1.25) D	1238	55	1			





Sec. 6

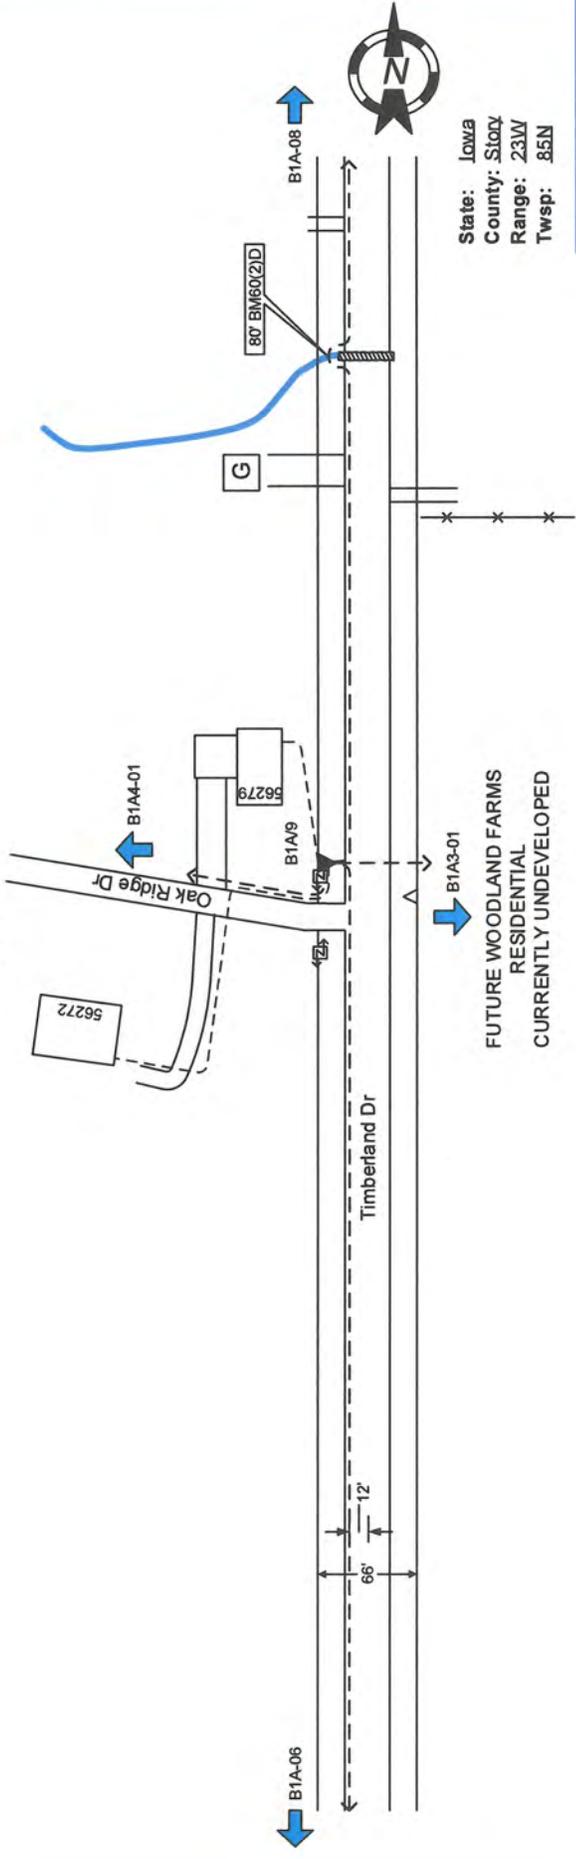


**As Staked**  
**Complete Communications**  
 Name: B1A-07  
 WO: VPS\_STORY\_19  
 Exch: Story City  
 Route: B1A  
 ROW: PUBLIC  
 Staked By: SEC Date: 07/20/21  
 Revised By: Date:  
 Plowed By: Date:  
 Tabbed By: Date:  
  
 Drawing Not to Scale

Sheet	7	of	10
-------	---	----	----

Sec. 6

From	To	PType	Units	Feet	BM	HO	ONT	Remarks
B1A/8	B1A/9	BDO5TSB	BFO 144RW	1608	2(5/8)(8)	1	8	
	B1A/9				60(2)D	80	12	4
B1A/8	56272		SEBO 4	296	83	1		HS
B1A/8	56279		SEBO 4	166	83	1		HS



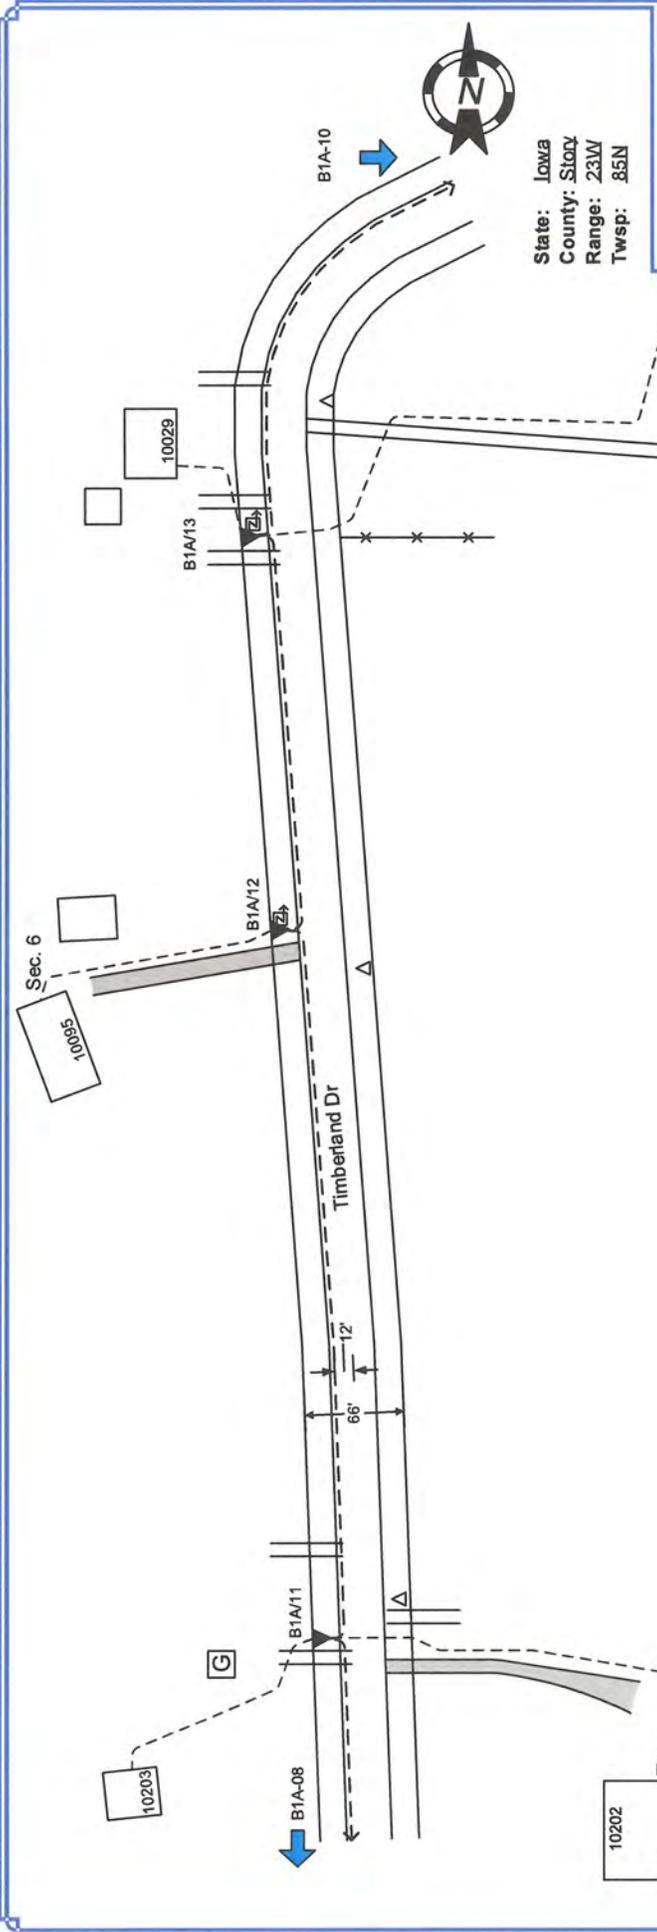

State: Iowa  
 County: Story  
 Range: 23W  
 Twp: 35N



**As Staked**

**Complete Communications**

Name: B1A/08  
 WO: VES STORY, IA  
 Exch: Story City  
 Route: B1A  
 ROW: PUBLIC

Staked By: SEC Date: 01/2021  
 Revised By: Date:  
 Plowed By: Date:  
 Tabbed By: Date:

**VantagePoint**  
 Drawing Not to Scale

Sheet	9	of	10
-------	---	----	----

From	To	PType	Units	Feet	BM	HO	ONT	Remarks
B1A/10	B1A/11	BDO5TSB	BFO 24RW	1060	2(5/8) (8)	1	2	
B1A/11	10202		SEBO 4	390	83	1		HS
B1A/11	10203		SEBO 4	240	83	1		HS
B1A/11	B1A/12	BDO5TSB	BFO 24RW	568	2(5/8) (8)	1	1	
B1A/12	10095		SEBO 4	250	83	1		HS





State: Iowa  
 County: Story  
 Range: 23W  
 Twsp: 35N

**As Staked**

**Complete Communications**


Name: B1A2-01  
 WO: VPS\_STOREY\_19  
 Exch: Story City  
 Route: B1A2  
 ROW: PUBLIC

Staked By: SEC Date: 01/20/21  
 Revised By: Date:  
 Plowed By: Date:  
 Tabbed By: Date:

**VantagePoint**

Drawing Not to Scale

Sheet 1 of 2

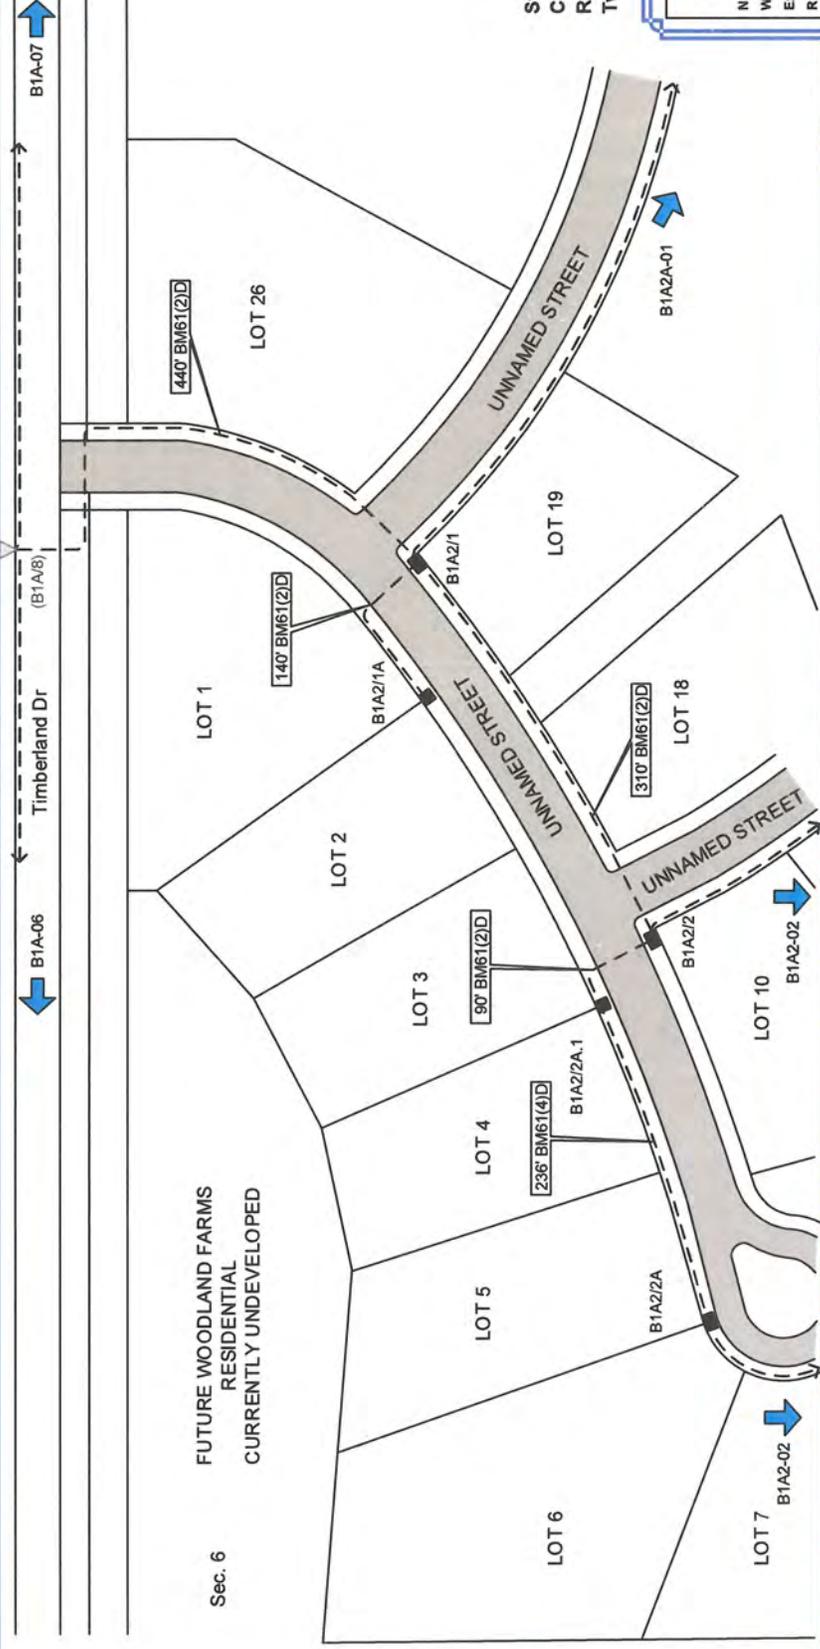

Sec. 6  
 FUTURE WOODLAND FARMS  
 RESIDENTIAL  
 CURRENTLY UNDEVELOPED

From	To	P Type	Units	Feet	BM	HBFO	HO	Remarks
B1A/8	B1A2/1	BHF(30x48x36)T	BFO 48R1	540	2(5/8)(8)	M 1	1	
B1A2/1	B1A2/1		BM51 4(50)I	1	6(2)D			
B1A/8	B1A2/1		BFOV(1x1.25)	440				
B1A2/1	B1A2/1A	BHF(11x11x18)	BFOV(1x1.25)	140	6(2)D			
B1A2/1	B1A2/2	BHF(30x48x36)T	BFO 48R1	410	2(5/8)(8)	M 1	1	
B1A2/2	B1A2/2		BM51 4(50)I	1	6(2)D			
B1A2/1	B1A2/2		BFOV(1x1.25)	310				




State: Iowa  
 County: Story  
 Range: 23W  
 Twsp: 85N

**As Staked**  
**Completa Communications**  
 Name: B1A2-02  
 WO: VPS\_STORY\_19  
 Exch: Story City  
 Route: B1A2  
 ROW: PUBLIC

Staked By: SEC Date: 01/20/22  
 Revised By: Date:  
 Plowed By: Date:  
 Tabbed By: Date:

**VantagePoint**  
 Drawing Not to Scale

Sheet	2	of	2
-------	---	----	---

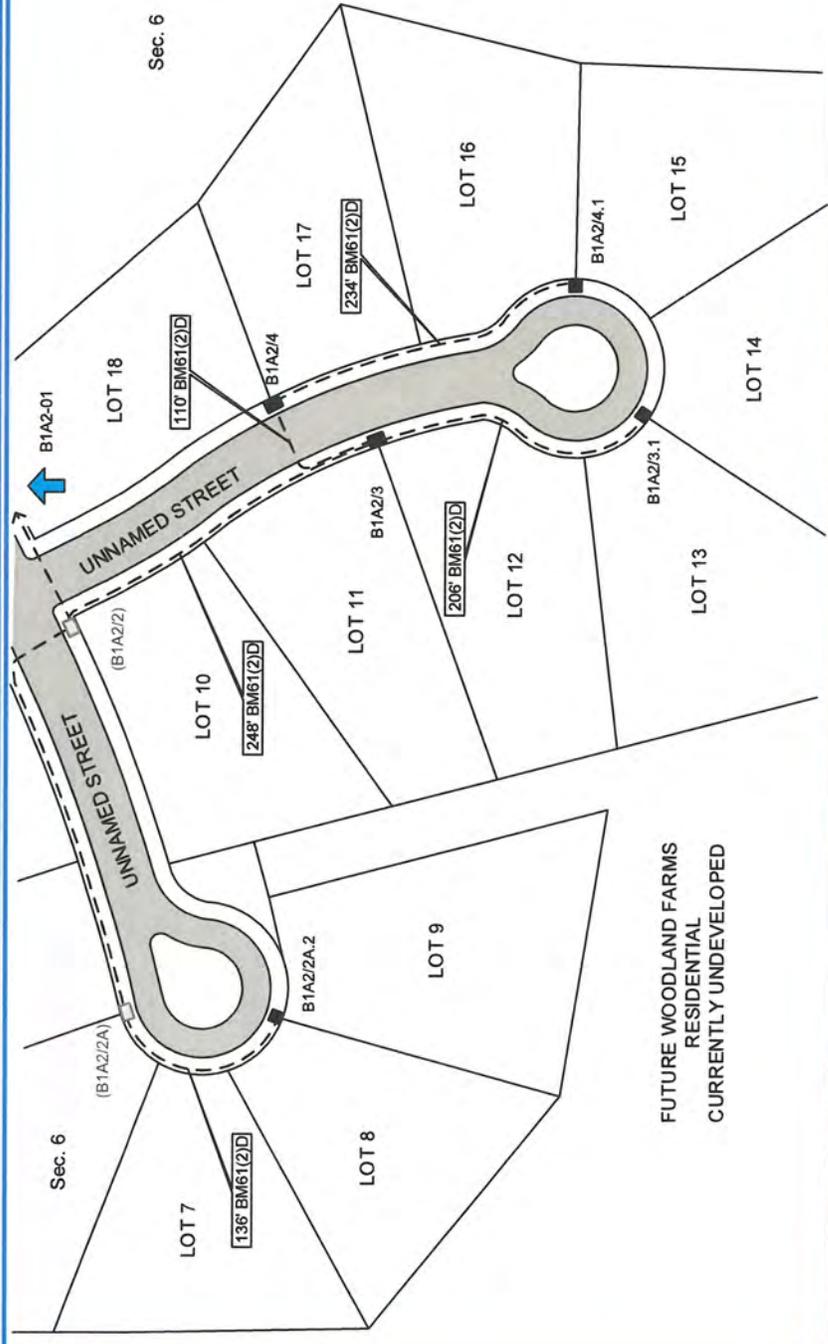

FUTURE WOODLAND FARMS  
 RESIDENTIAL  
 CURRENTLY UNDEVELOPED

From	To	P Type	Units	Feet	BM	Remarks
(B1A2/2A)	B1A2/2A.2	BHF(11x11x18)	BF OV(1x1.25)	136	61(2)D 136	
B1A2/3	B1A2/3	BHF(17x30x24)	BM51 4(300)	1	2(5/8)(8) 1	
(B1A2/2)	B1A2/3		BF OV(1x1.25)	248	61(2)D 248	
B1A2/3	B1A2/3.1	BHF(11x11x18)	BF OV(1x1.25)	206	61(2)D 206	
(B1A2/2)	B1A2/4	BHF(17x30x24)	BM51 4(500)	1	2(5/8)(8) 1	
B1A2/3	B1A2/4		BF OV(1x1.25)	110	61(2)D 110	



Sec. 6

State: Iowa  
 County: Story  
 Range: 23W  
 Twp: 85N

**As Staked**

**Complete Communications**


Name: B1A2A.1  
 WO: VES\_STORY\_18  
 Exch: Story City  
 Route: B1A2A  
 ROW: PUBLIC

Staked By: SEC Date: 01/20/22  
 Revised By: Date:  
 Plowed By: Date:  
 Tabbed By: Date:



Drawing Not to Scale

Sheet	1	of	1
-------	---	----	---

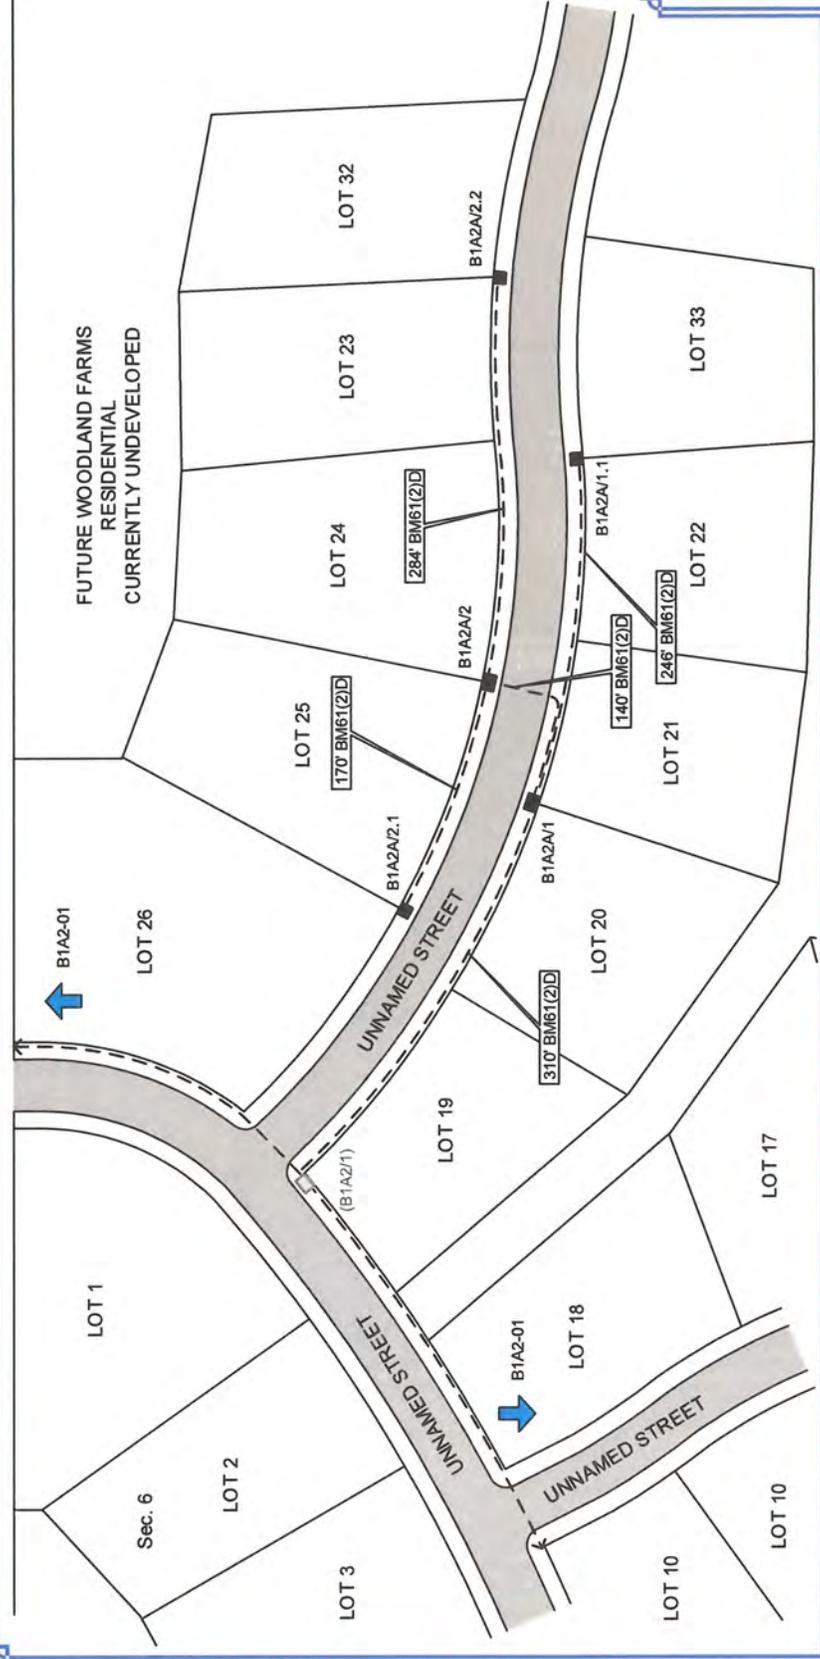

From	To	P Type	Units	Feet	BM	Remarks
(B1A2/1)	B1A2A/1	BHF(17x30x24)	BM51 4(400)	1	2(5/8)(6)	1
	B1A2A/1		BFOV(1x1.25)	310	6(2)D	310
				246	6(2)D	246
				1	2(5/8)(6)	1
				140	6(2)D	140
				170	6(2)D	170

FUTURE WOODLAND FARMS  
 RESIDENTIAL  
 CURRENTLY UNDEVELOPED



State: Iowa  
 County: Story  
 Range: 23W  
 Twsp: 85N

Sec. 6

**As Staked**

**Complete Communications**


Name: B1A3/1  
 WO: VPS STORY\_19  
 Exch: Story City  
 Route: B1A3  
 ROW: PUBLIC

Staked By: SEC Date: 01/20/20  
 Revised By: Date:  
 Plowed By: Date:  
 Tabbed By: Date:



Drawing Not to Scale

Sheet 1 of 2

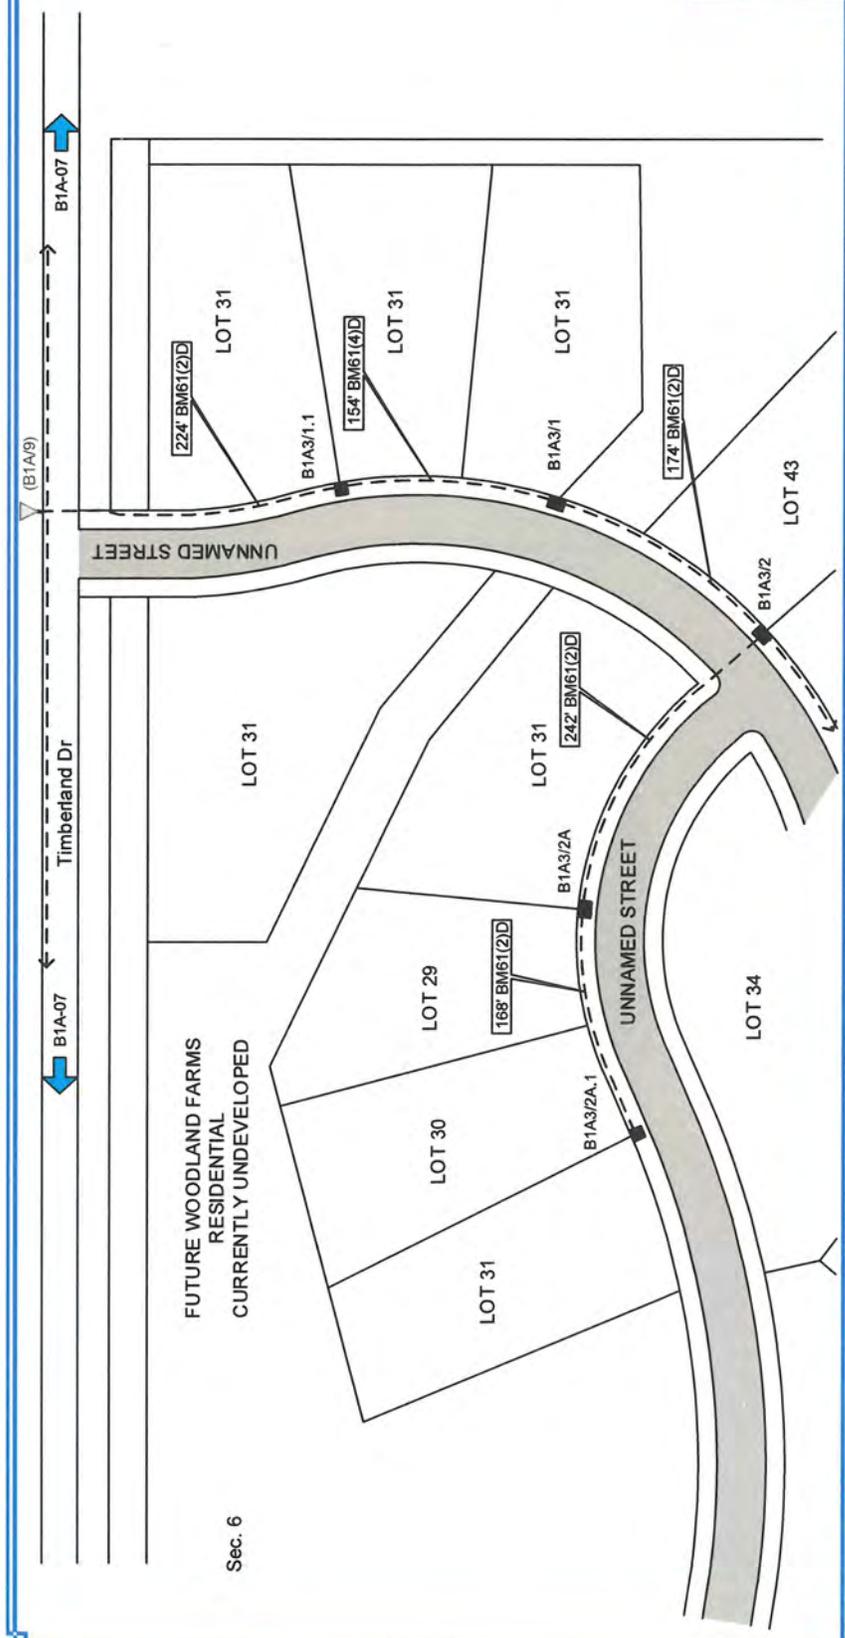

From	To	P Type	Units	Feet	BM	Remarks
(B1A/9)	B1A3/1.1	BHF(11x11x18)	BFO 48RI	290	2(5/8)(8)	1
	B1A3/1.1		BFOV(1x1.25)	224	61(2)D	224
B1A3/1.1	B1A3/1	BHF(17x30x24)	BFO 48RI	204	2(5/8)(8)	1
B1A3/2	B1A3/1		BM51 4(300)	1	61(4)D	154
B1A3/1.1	B1A3/1		BFOV(1x1.25)	154		
B1A3/1	B1A3/2	BHF(30x48x36)T	BFO 48RI	224	2(5/8)(8)	1
B1A3/2	B1A3/2		BM51 4(50)	1	61(2)D	174

FUTURE WOODLAND FARMS  
 RESIDENTIAL  
 CURRENTLY UNDEVELOPED

Sec. 6

B1A-07

B1A-07

(B1A/9)

Timberland Dr

B1A-07

UNNAMED STREET

UNNAMED STREET

LOT 31

LOT 31

LOT 31

LOT 31

LOT 29

LOT 31

LOT 30

LOT 31

LOT 34

LOT 43

224' BM61(2)D

B1A3/1.1

154' BM61(4)D

B1A3/1

174' BM61(2)D

242' BM61(2)D

B1A3/2A

168' BM61(2)D

B1A3/2A.1

B1A3/2





State: Iowa  
 County: Story  
 Range: 23W  
 Twp: 85N


**As Staked**  
**Completa Communications**

Name: B1A4-01  
 WO: VPS\_STORY\_19  
 Exch: Story City  
 Route: B1A4  
 ROW: PUBLIC

Staked By: SEC Date: 01/20/23  
 Revised By: Date:  
 Plowed By: Date:  
 Tabbed By: Date:



Drawing Not to Scale  
 Sheet 1 of 1

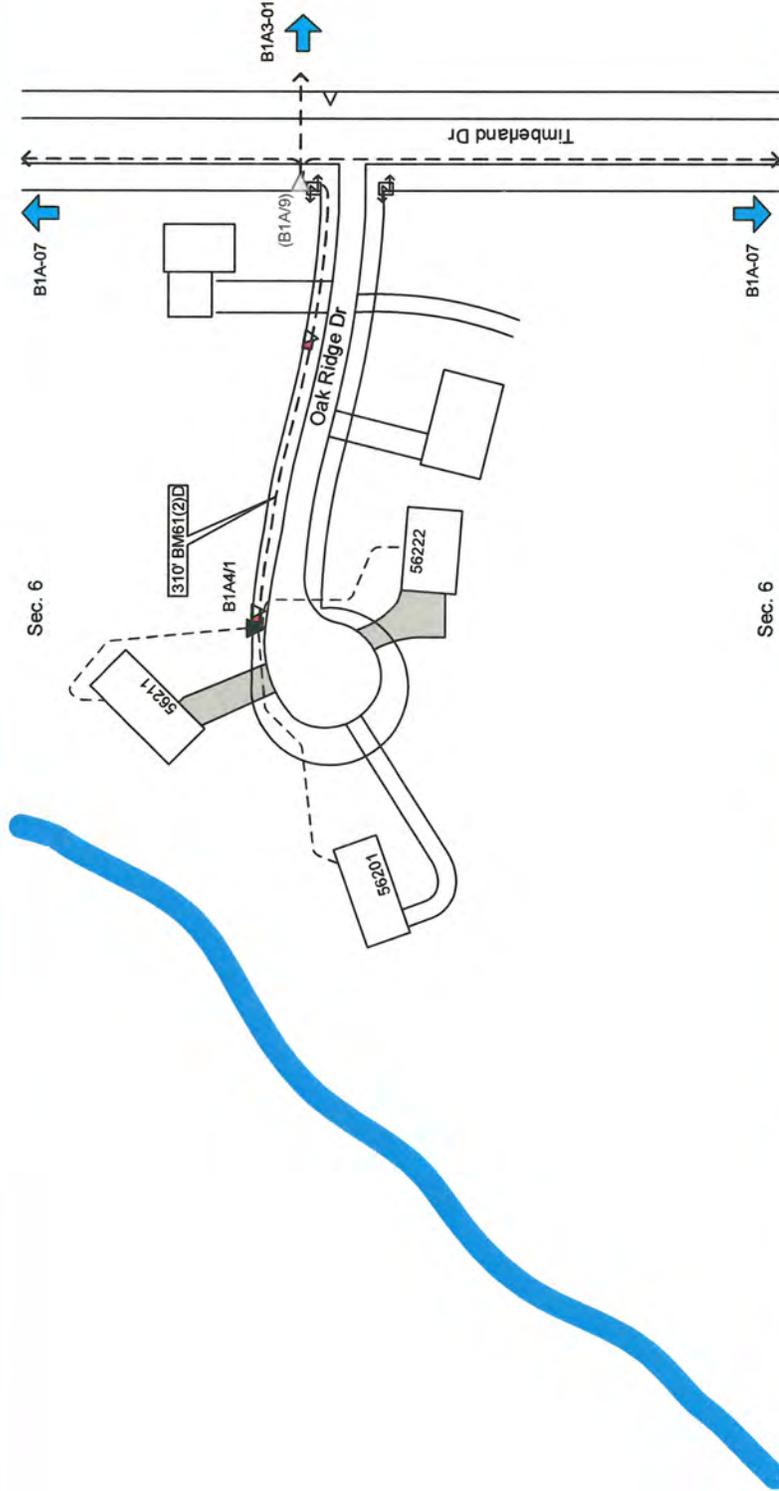

From	To	PType	Units	Feet	BM	HO	ONT	Remarks
(B1A/9)	B1A4/1	BDO5TSB	BFO 12RI	356	2/5/8(8)	1	3	
	B1A4/1		BFOV(1x1.25)	316	61(2)D	310		
B1A4/1	56211		SEBO 4	210	83	1		HS
B1A4/1	56201		SEBO 4	250	83	1		HS
B1A4/1	56222		SEBO 4	208	83	1		HS

Section 18

Wooded Area

Wooded Area

Wooded Area



State: Iowa  
 County: Story  
 Range: 23W  
 Twp: 85N


**As Staked**  
**Complete Communications**

Name: B3-D1  
 WO: VES\_STORY\_18  
 Exch: Story\_City  
 Route: B3  
 ROW: Public  
 Staked By: TM Date: 1-19  
 Revised By: Date:  
 Plowed By: Date:  
 Tabbed By: Date:



Drawing Not to Scale

Sheet 1 of 1

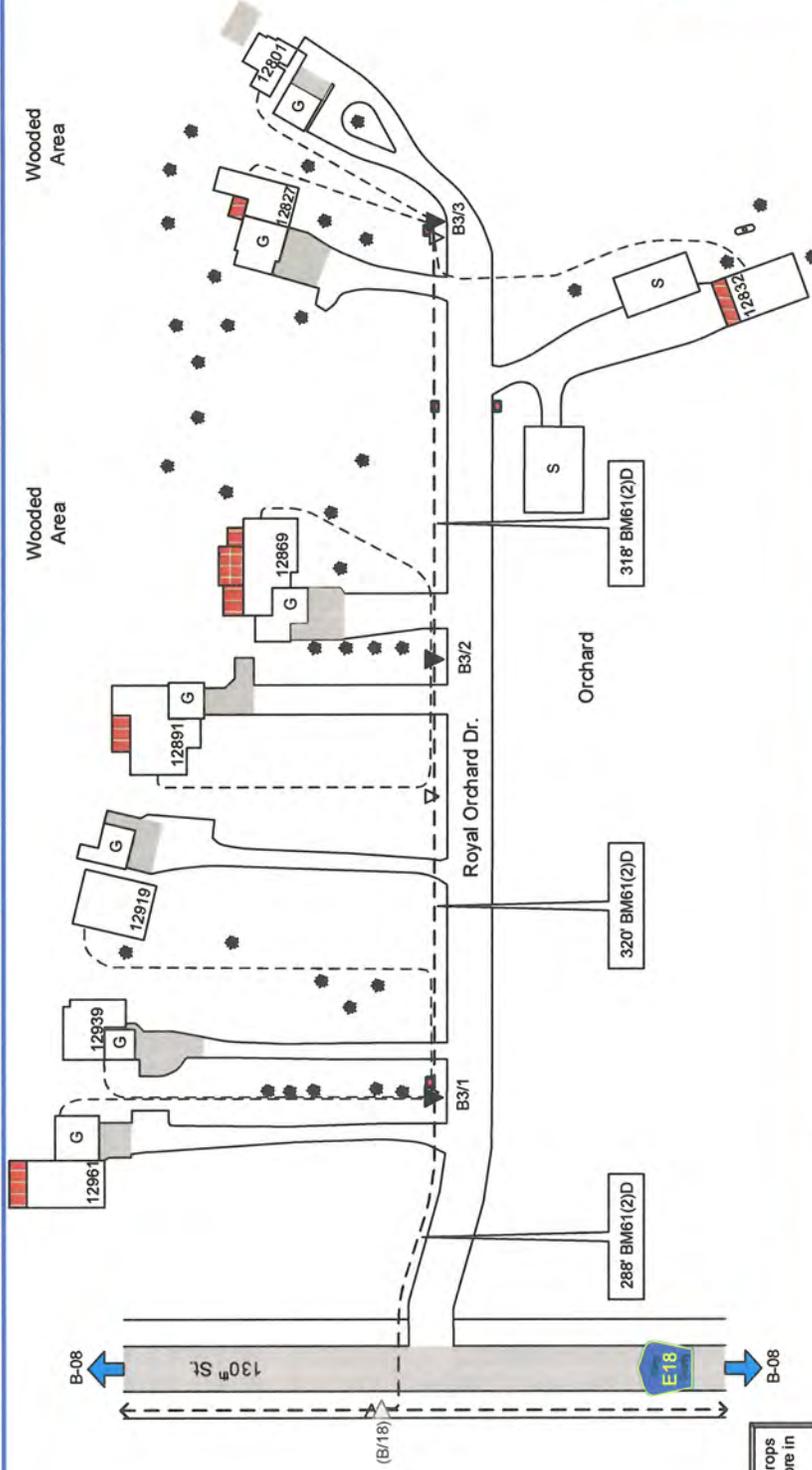

From	To	PType	Units	Feet	BM	HO	ONT	Remarks
(B/18)	B3/1	BDO5T/SB	BFO 48R1	332	2(5/6)(8)	1	3	
	B3/1		BFOV(1x1.25)	292	61(2)D	288		
B3/1	12919		SEBO 4I	400	83	1		Sub 12919
	12919		SEBOV(1x.75)	370				
B3/1	12939		SEBO 4I	298	83	1		Sub 12939
	12939		SEBOV(1x.75)	268				



State: Iowa  
 County: Story  
 Range: 35W  
 Twp: 85N

**As Staked**  
**Complete Communications**


Name: B4-01  
 W/O: VES\_STORY\_19  
 Exch: Story City  
 Route: B4  
 ROW: Easle  
 Staked By: TM Date: 1-19  
 Revised By: Date:  
 Plowed By: Date:  
 Tabbed By: Date:



Drawing Not to Scale

Sheet 1 of 4

Section 18

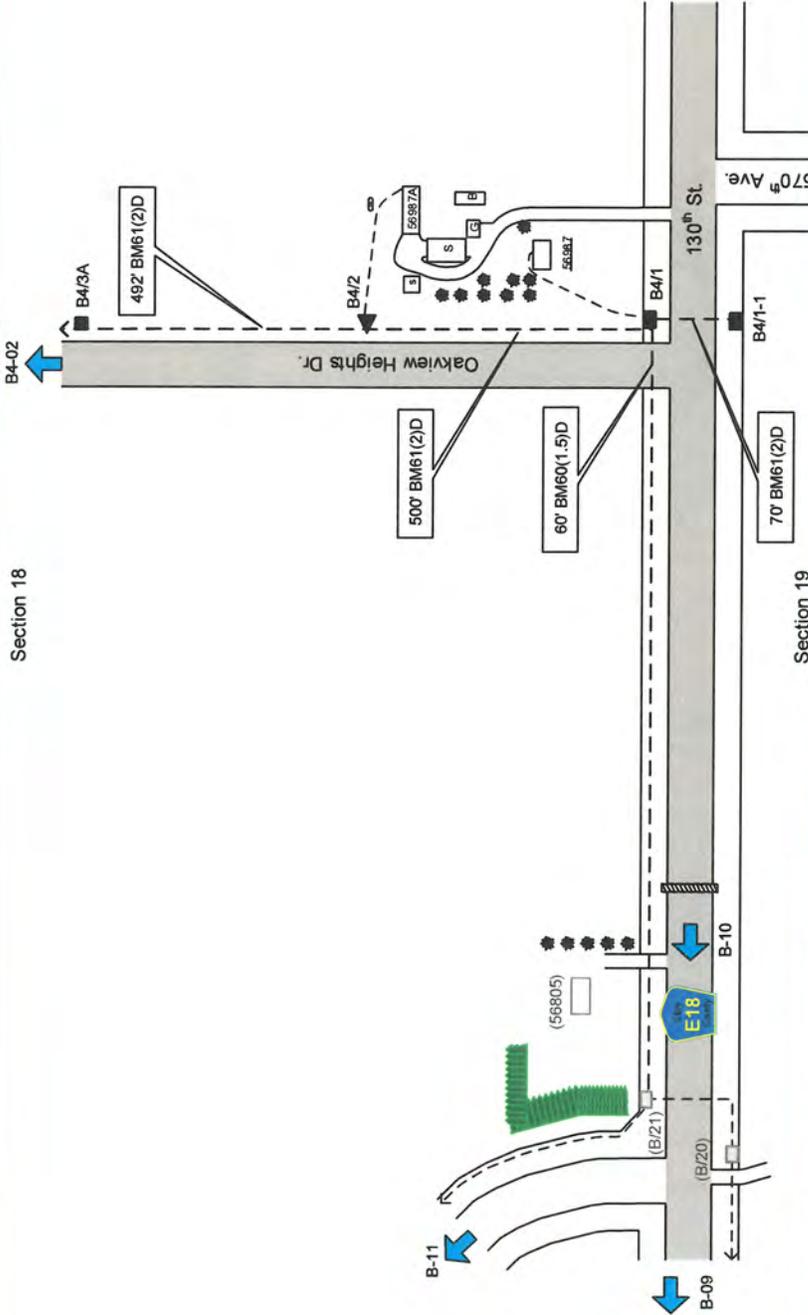

1/2 mile sheet

From	To	PType	Units	Feet	BM	HBFO	HO	ONT	W	Remarks
(B/21)	B4/1	BHF(36x60x36)	BFO 288RW	1556	2(5/8)Ø	1	M	1	1	
	B4/1			55						
	B4/1			60(1.5)D	60					
B4/1	56987		SEBO 4	370	83	1				Sub 56987
B4/1	B4/1-1	E(BHF(30x46x36))	BFO 288RI	228	6(2)D	70	M	1		BHF 1
B4/1-1	B4/1-1		BFOV(1x1.5)	128						50' Coil



State: Iowa  
 County: Story  
 Range: 23W  
 Twp: 85N

**As Staked**


**Completa Communications**

Name: B4-02  
 WO: VPS\_STOREY\_19  
 Exch: Story City  
 Route: B4  
 ROW: Public

Staked By: TM Date: 1-19  
 Revised By: Date:  
 Plowed By: Date:  
 Tabbed By: Date:

Drawing Not to Scale

Sheet	2	of	4
-------	---	----	---

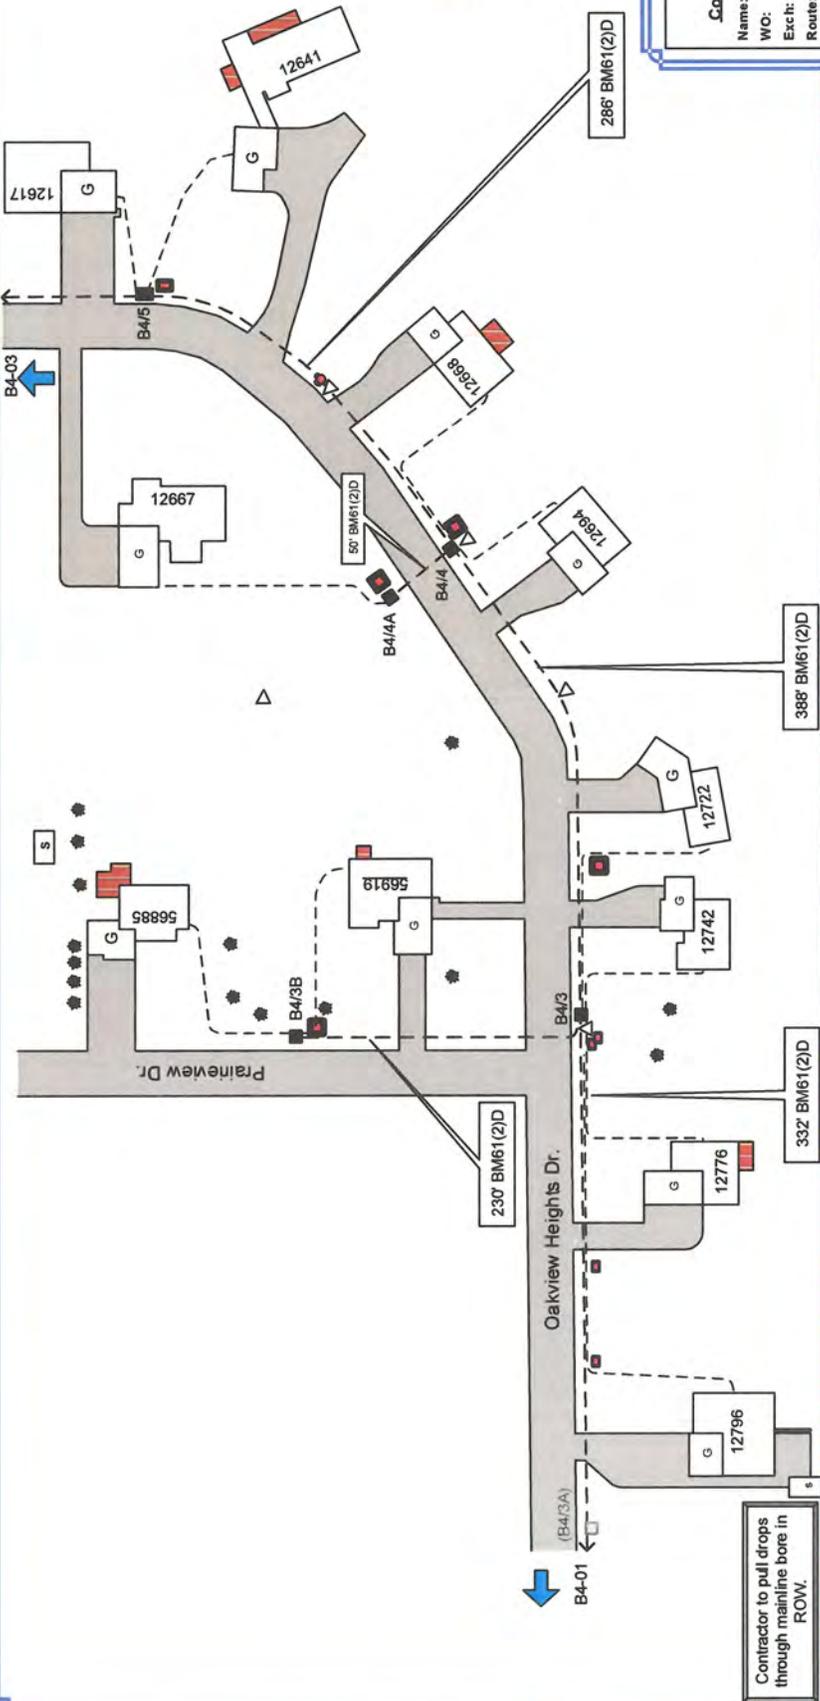


From	To	PType	Units	Feet	BM	HBFO	HO	ONT	Remarks
B4/3A	B4/3	BHF(17x30x24)	BFO 48R1	332	2(5/8)(8)	1			
B4/5	B4/3	BM51 8(750)I		1	61(2)D	332			Splices @ B4/5
B4/3A	B4/3	BFOV(2x1.25)		342					
B4/3	12742	SEBO 1(200)I		1	83	1		H	Sub 12742
	12742	SEBOV(1x.75)		120					
B4/3	12722	SEBO 1(300)I		1	83	1		H	Sub 12722
	12722	SEBOV(1x.75)		260					

Contractor to pull drops through mainline bore in ROW.



State: Iowa  
 County: Story  
 Range: 23W  
 Twp: 35N

**As Staked**  
**Complata Communications**  
 Name: B4-03  
 WO: VPS\_STORY\_19  
 Exch: Story\_City  
 Route: B4  
 ROW: Public  
 Staked By: JAS Date: 01/09/12  
 Revised By: Date:  
 Plowed By: Date:  
 Tabbed By: Date:  
  
 Drawing Not to Scale  
 Sheet 3 of 4

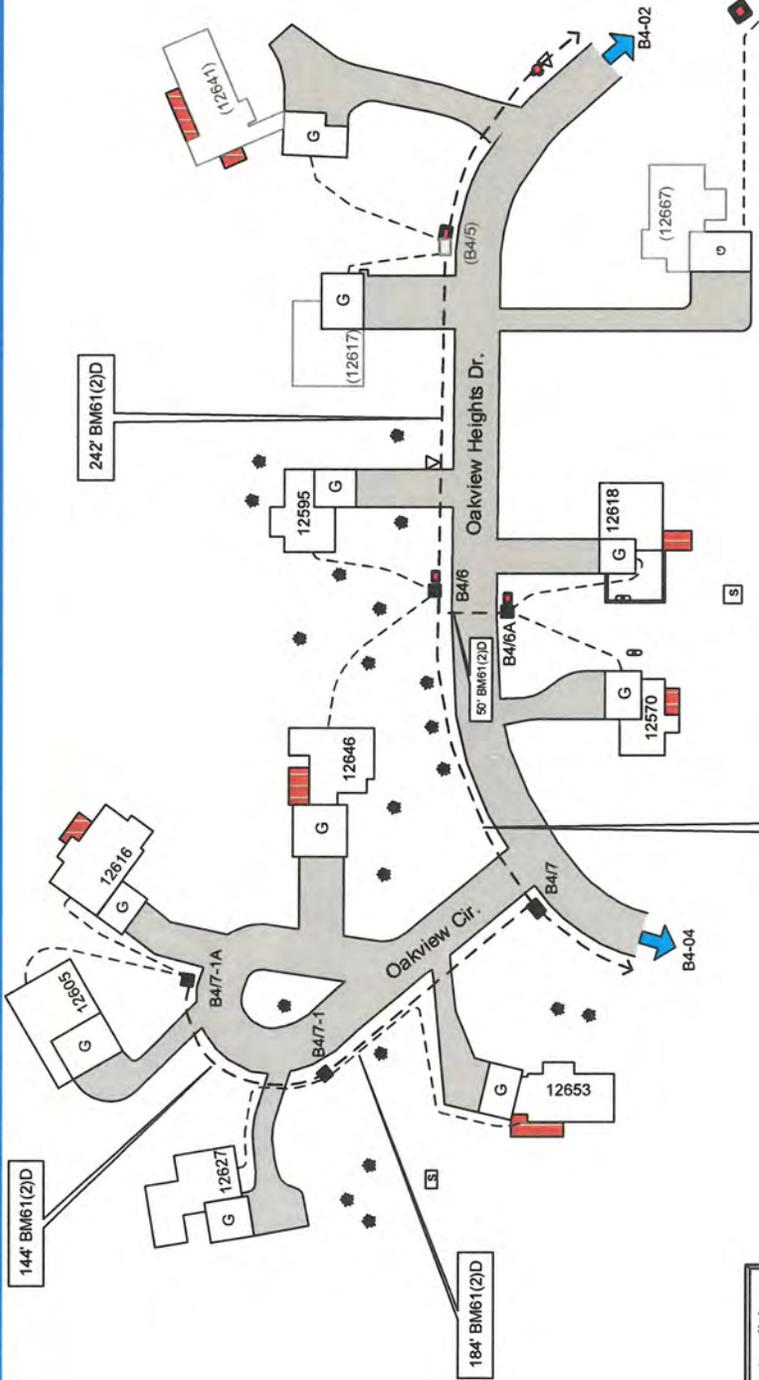

Contractor to pull drops through mainline bore in ROW.

From	To	PType	Units	Feet	BM	HBFO	HO	ONT	Remarks
B4/5	B4/6	BHF(17x30x24)	BFO 48R1	302	2/(5/8)(8)	1			
	B4/6		BM51 6(500)I	1	61(2)D	242			Splices @ B4/5
	B4/6		BFOV(2x1.25)	252					
B4/6	12595		SEBO 1(200)I	1	83	1		H	Sub 12595
	12595		SEBOV(1x.75)	120					
B4/6	12646		SEBO 1(200)I	1	83	1		H	Sub 12646
	12646		SEBOV(1x.75)	130					



State: Iowa  
 County: Story  
 Range: 23W  
 Twsp: 85N

**As Staked**


**Complete Communications**

Name: B4-04  
 W/O: VPS\_STORY\_19  
 Exch: Story\_City  
 Route: B4  
 ROW: Public

Staked By: TM Date: 1-19  
 Revised By: Date:  
 Plowed By: Date:  
 Tabbed By: Date:

Drawing Not to Scale

Sheet 4 of 4

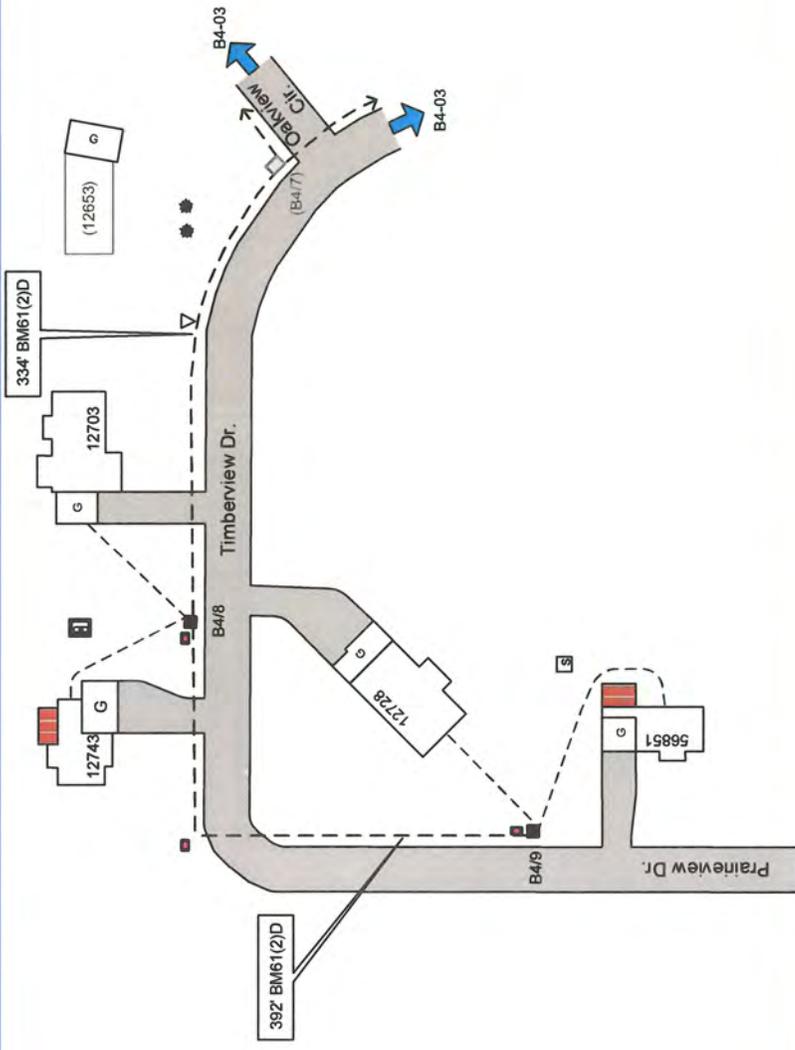


From	To	PType	Units	Feet	BM	ONT	Remarks
(B4/7)	B4/8	BH-F(17x30x24)	BM51 4(500)I	1	2(5/8)(8)	1	Splices @ B4/7
	B4/8		BFOV(1x1.25)	344	6(2)D	334	
B4/8	12703		SEBO 1(200)I	1	83	1	Sub 12703
	12703		SEBO V(1x.75)	120			
B4/8	12743		SEBO 1(200)I	1	83	1	Sub 12743
	12743		SEBO V(1x.75)	150			









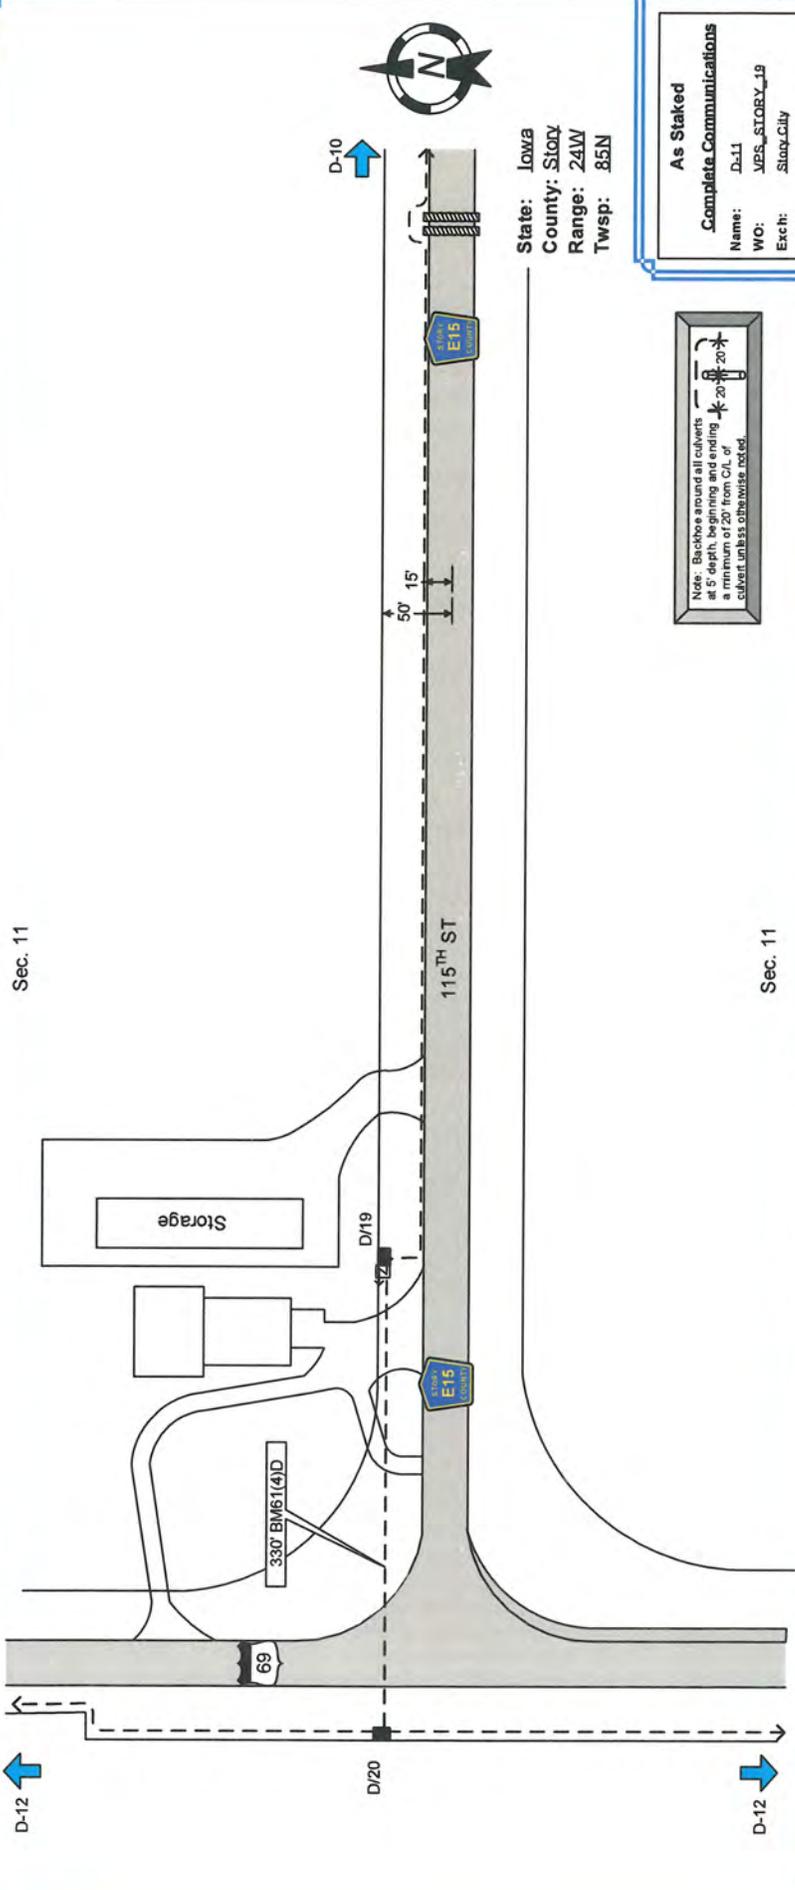

Sec. 11

Sec. 11

State: Iowa  
 County: Story  
 Range: 24W  

**As Staked**

**Complete Communications**

Name: D-11  
 WO: VPS\_STORY\_19  
 Exch: Story City  
 Route: D  
 ROW: PUBLIC

Staked By: SEC Date: 1/20/20  
 Revised By: Date:  
 Plowed By: Date:  
 Tabbed By: Date:

**VantagePoint**  
 Drawing Not to Scale

Note: Backhoe around all culverts at 5' depth beginning 20' from centerline of culvert unless otherwise noted.

From	To	PType	Units	Feet	BM	HBFO	HO	Remarks
D/18	D/19	BHF(30x48x36)T	BFO 96RI	1954	2(5/8)(8) 1	M 1		
	D/19		BFOV(1x1.25) & BFOV(1x1.5) D	1854				
D/19	D/20	BHF(30x48x36)T	BFO 96RI	430	2(5/8)(8) 1	M 1	12	3
	D/20		BFOV(1x1.25) & BFOV(1x1.5) D	330	61(4)D 330			

## STORY COUNTY UTILITY PERMIT

Date 2/20/20

To the Board of Supervisors, Story County, Iowa:

The MINOSTREAM COMMUNICATION Company, incorporated under the laws of authorize to do business within the State of Iowa, with its principal place of business at LITTLE ROCK, AR, does hereby make application requesting permission to occupy certain portions of public right-of-way and that the County Engineer be directed to establish the location of lines of transmission of FIBER CABLE on secondary route 295<sup>TH</sup> ST, from 650<sup>TH</sup> AVE to 996' EAST, a distance of 0.19 miles.

Agreements: The utility company, corporation, applicant, permittee, or licensee, (hereinafter referred to as the permittee) agrees that the following stipulations shall govern under this permit.

1. The Permittee will file a plat setting out the location of proposed line on the secondary route and that the description of the proposed installation including type, height, and spacing of poles, maximum voltage, lengths of cross arms, minimum clearance and number of wires, type, size and capacity of underground cables, conduits, tile lines, and pipe lines, maximum working pressures for pipe lines carrying gas or flammable petroleum products are described as follows:
2. The installation shall meet the requirements of county, state, and federal laws, franchise rules, and of the Iowa State Commerce Commission Regulations and Directives, Utilities Division, the Iowa State Department of Health, and any other laws or regulations applicable.
3. The Permittee shall be fully responsible for any future adjustments of its facilities within the established highway right-of-way caused by highway construction or maintenance operations.
4. Story County assumes no responsibility for damages to the Permittee's property occasioned by any construction or maintenance operations on said highways.
5. The Permittee shall take all reasonable precautions during the construction and maintenance of said installation to protect and safeguard the lives and property of the traveling public and adjacent property owners.
6. The Permittee, and its contractors, shall carry on the construction or repair of the accommodated utility with serious regard to the safety of the public. Traffic protection shall be in accordance with Part VI of the current Iowa Department of Transportation Manual on Uniform Control Devices for Streets and Highways.
7. The Permittee shall be responsible for any damage resulting to said highways because of the construction operation, or maintenance of said utility, and shall reimburse Story County for any expenditure the County may have to make on said highways because of said permittee's utility having been constructed, operated, and maintained thereon.
8. The Permittee shall indemnify and save harmless Story County from any and all causes of action, suits at law or in equity, or losses, damages, claims, or demands, and from any and all

liability and expense of whatsoever nature for, on account of or due to the acts or omissions of said Permittee's officers, members, agents, representatives, contractors, employees or assigns arising out of or in connection with its (or their) use or occupancy of the public highway under this permit.

9. Noncompliance with any of the terms of permit, or agreement, may be considered cause for shut down of utility construction operations, or revocation of the permit.

10. The following special requirements, if applicable, shall apply to this permit:

Whenever the route of the proposed cable line runs along a paved secondary highway, the location of said cable shall be constructed on top of the road shoulder so as to be within approximately two-feet of the pavement edge.

Whenever the route of the proposed cable line runs along a dirt or gravel surfaced highway, the location of said cable shall be constructed on top of the road surface and as near possible to the shoulder line

Whenever a cross road culvert or bridge is encountered along the route of the proposed cable lines, said cable shall be constructed around the ends of said cross road culvert or bridge even though this looping is not designated on the situation plans attached hereto.

The crossing of the cable line from one side of the highway to the other shall be accomplished at a near right angle rather than diagonally so as to disturb the roadbed of the traveled way as little as possible.

Whenever the route of the proposed cable line is to cross a paved highway, such crossing shall be in a bored hole rather than open cut trench.

Date 2/14/2020

WINDSTREAM COMMUNICATIONS  
Name of Company (Applicant - Permittee)

LUKE MILES 521-748-5893  
by (LUKE MILES) Phone no.

Recommended for Approval:

Date 2-20-20

James Moon 515-382-7355  
County Engineer Phone no.

Approved:

Date 2/25/2020

Shudakher  
Chair, Board of Supervisors  
Story County, Iowa

Three (3) copies of this form will be required for each installation. A plat shall be attached to each copy submitted.

Farm-to-Market Road System Map

**STORY COUNTY**  
IOWA



Scale: 1" = 1 Mile  
0 1 2 Miles



Legend:

- Major Roadway
- Minor Roadway
- Proposed Roadway
- Water
- County Boundary
- City Boundary
- Unimproved Roadway
- Right-of-Way
- Other

Farm-to-Market System as of:  
12-4-2017  
Verified by Office of  
Farm-to-Market Review Board

Signature: \_\_\_\_\_ On File  
Date: \_\_\_\_\_


Based on Farm-to-Market Review Board  
Meeting Report:  
12-4-2017

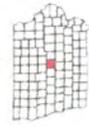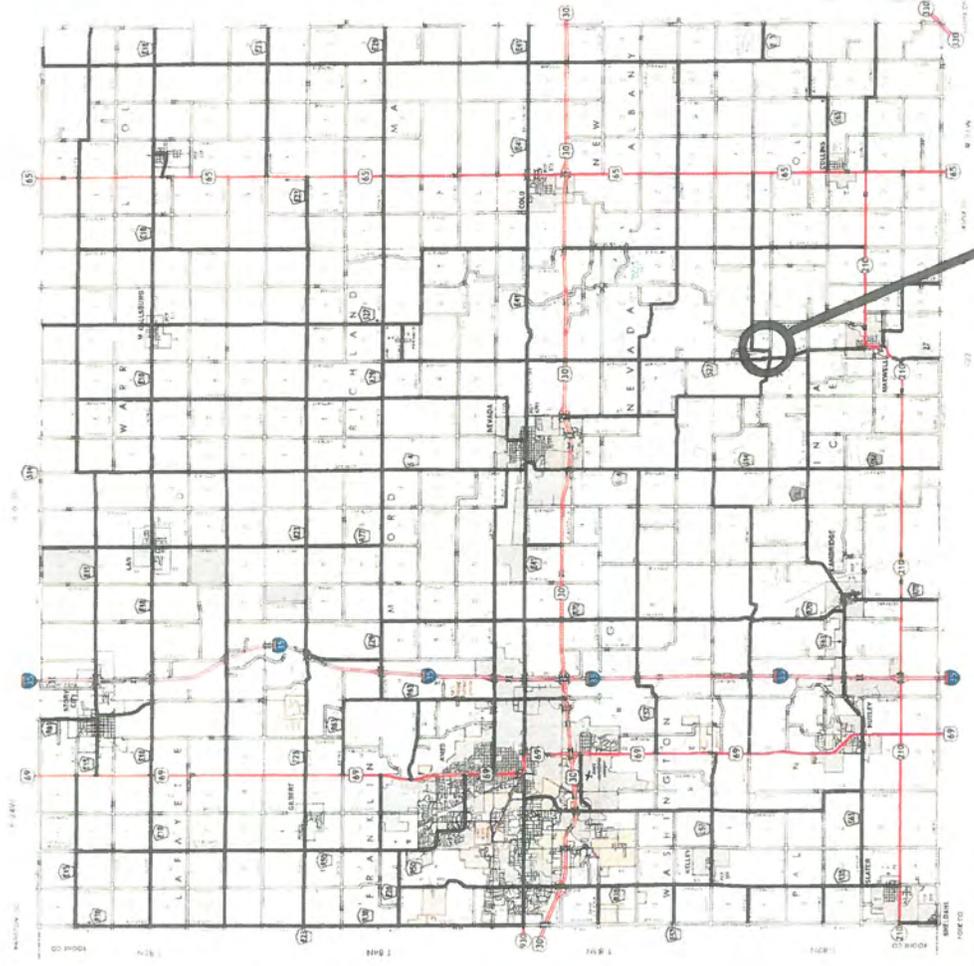

WORK AREA  
713309081-00004



DRAFTER NOTE:  
NEED TO CARRY NEW  
COUNT TO END OF  
LEADS ON FID: 200254083  
AND 2003010152

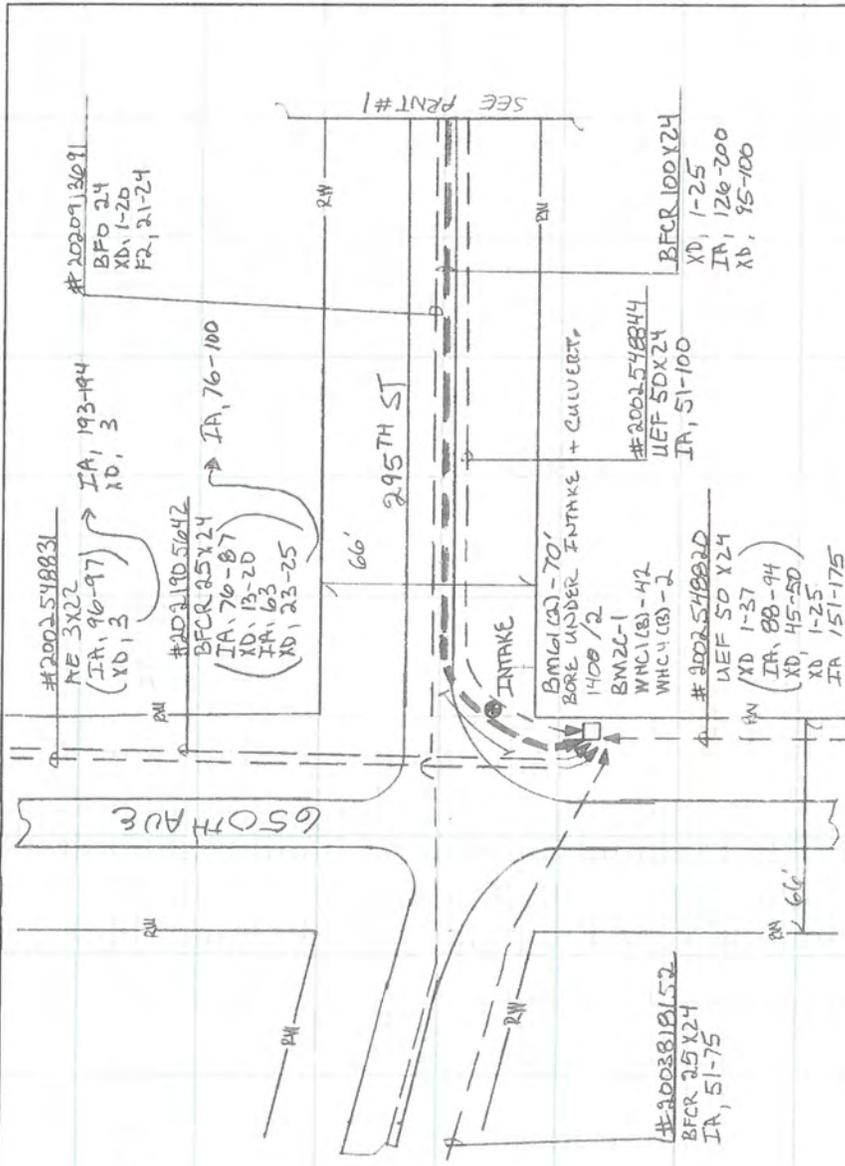

SEE PRINT #1

UNIT CODE	ESTIMATED QUANTITY	AS BUILT QUANTITY
BM(103)	70	
BMC20	4	
WMC1(8)	2	
WMC4(8)		

NOTE AREA:  
STORY COUNTY  
INDIAN CREEK TWP  
SEC. 10  
PLACE CABLE AT A  
MINIMUM 30" DEPTH  
AS NEAR TO EDGE OF  
ROAD AS POSSIBLE.

windstream.

ALL KNOWN OBSTRUCTIONS HAVE BEEN SHOWN  
THOSE AND OTHERS, IF ANY, ARE THE RESPONSIBILITY  
OF THE CONTRACTOR OR THE WINDSTREAM CREW.

CALL ONE-CALL: 1-800-292-8989  
48 HOURS PRIOR TO CONSTRUCTION.

EXCH #	EXCH NAME	REM. CODE
713307081	MAXWELL	
WOF	713307081-0004	TAX DIST.
TITLE	INDIAN CREEK TWP	
TWP	INDIAN CREEK TWP	SEC. 10
DATE	2-15-2020	REV. DATE
FILE	JLW	APPV'D
	JLW	ENG
	JLW	DRWN
	JLW	SCALE
	JLW	PRINT #
	JLW	20F2

01/29/2020

Story County Board of Supervisors  
Story County Administration Building  
900 6th Street  
Nevada, IA 50201

Dear Supervisors,

Hello, my name is Wayne Selle, I am writing in regards to the employee agreement with Story County. It was not my intention to break the contract. I was planning on staying and fulfilling my contract, but due to the unforeseen circumstances that occurred I was forced to. At this stage I am currently unemployed and seeking another position elsewhere. I will not be able to make a lump sum payment of \$27,363.74 within 60 days of ending my employment.

Due to the fact that I have two small children and a mortgage, I am unable to pay the amount of the agreement (\$27,363.74) in full by the deadline of March 02, 2020. I am respectfully presenting two alternative options.

The first alternative is making small monthly payments until the debt is satisfied. At this stage, being unemployed, the payments that I have the ability to make would be very low. After I get a job, it would be dependent on my new salary what I would be able to budget for a monthly payment.

The second alternative is I can pay the amount of \$8,746.00 from my savings on 03/02/2020 with the understanding the debt to the county would be completely satisfied. With my savings depleted I would not be able to make payments in the future. This would be a lump sum amount for the following;

ILEA Tuition:	\$6,240.00
ILEA PIT Certification:	\$125.00
ILEA Meals:	\$1,849.00
ILEA Uniforms:	\$225.00
Deputy Uniforms that were returned:	\$306.31

With my current financial situation, and being unemployed, I would only be able to pay this amount (8,746.00) from my savings knowing the debt would be completely satisfied.

Thank you for your time and consideration in this situation.

Sincerely,  
Wayne Selle

**APPROVED** **DENIED**  
Board Member Initials: gmr  
Meeting Date: 2-25-2020  
Follow-up action: HR to issue a letter of satisfaction to Mr. Selle

*in the amount of  
\$8,539*



# Sheriff's Office

Story County  
PAUL H. FITZGERALD, Sheriff



Emergency 911 • Office: 515-382-6566 • Fax #: 515-382-7479 • P.O. Box 265 • Nevada, Iowa 50201

February 20, 2020

Story County Board of Supervisors  
Linda Murken, Chairperson  
Lisa Heddens  
Lauris Olsen

FILED  
20 FEB 21 PM 12:59  
STORY COUNTY AUDITOR

Board of Supervisors;

On Friday, February 14<sup>th</sup>, I met in the Sheriff's Office Conference Room with County Attorney Tim Meals, Assistant County Attorney Ethan Anderson, Story County Director of Internal Operations and Human Resources Alissa Wignall and Sheriff's Office Captain Nick Lennie. The Board of Supervisors (BOS) had received a letter from former Deputy Sheriff Wayne Selle requesting either all or part of the law enforcement contract be waived. The BOS has asked me for a recommendation on this request. After discussing this matter, it is my recommendation to modify the contract obligation for Mr. Selle to \$8,539.00. This amount includes reimbursement of the ILEA tuition, ILEA meals and ILEA uniforms.

Respectfully Submitted,

Paul H. Fitzgerald  
Story County Sheriff

## Board of Supervisors Report Outline

### Iowa Roadside Management Department

- IRVM has changed to Iowa Roadside Management (IRM) statewide
- Winter/Early Spring Operations
  - DD Work
    - Grant # 13(North of 265<sup>th</sup> Street) Logging operations halted 1/15/2020
      - There is still work to do cleaning up-stumps/burn piles at this site.
    - Currently staff is burning piles and doing site cleanup on Drainage Districts Hardin-Story #3, Warren #11, Grant #5 and New Albany #75.
    - Staff has worked with landowners to get access lanes planted on Hardin-Story #3 and Grant #5. This will be completed this spring if time, weather and resources allow.
    - Tyler is working with contractor to get bids for Contract Spray/logging of DD's. This would happen in the summer of 2021 or later.
  - No Spray Program
    - A contact list has been formed for Story County Sensitive Crop farmers. A letter is being drafted to inform them of No Spray Program and encourage involvement.
  - Safety Program
    - Job Safety Analysis forms are being created for SCC operations. IRM department is working to create JSA's for unique tasks performed by employees.
  - Drill Maintenance and Repair
    - CRP acres/waterways sign up has increased this year.
    - Staff is working on all 3 rental drills to prepare for a busy spring planting season.
  - Building Pad Preparation/ADA parking
    - Work has to be done on site to bring site to level, and create a proper base for concrete. This preconstruction work will be done by staff in the next few months.
- FY 2020 Purchasing
  - Isuzu NPR-HD cab over spray truck is in DSM getting flatbed and work lights installed.
  - Norstar Sprayer and GPS is currently being shipped from Washington.
  - Hydroseeder Truck replacement (2006 I.H. 7500 from Secondary Roads)
    - Truck is currently being used to plow snow, looking forward to warmer weather where truck can be sent to weld shop for hydroseeder installation.
  - 40 x40 pole building addition is planned to be built by July 1<sup>st</sup> 2020.
- FY 2021 Budget
  - 8-foot Truax Brillion seed drill
    - This Brillion seeder would replace 1996 8-foot drill currently in use.
    - It will work better for cool season plantings along trails and waterways, as well as being great for prairie plantings.
    - The 8-foot drill will go to DOT auction in October.
  - Tandem Axle Equipment Trailer
    - This project may be eligible for up to 80 % LRTF grant funding.
    - This trailer will replace the 1968 yellow trailer currently in use by IRM to haul small tractor and other equipment.
    - 1968 yellow trailer will be sold at DOT auction in October.

- Herbicide Storage Cage and shelving
  - This cage and shelving setup are designed to provide safe, spill proof, locked storage for herbicide containers inside new addition. This is in accordance with recommendations from ISU Extension Office and Iowa Department of Land Stewardship.
- Staffing
  - The new spray truck requires a minimum Class D CDL to operate. Seasonal staff are currently not required to have this license.
- Looking Ahead
  - Staff Affiliations/Committees 2019/2020
    - President AFIRM- Joseph Kooiker
    - Member at Large AFIRM-Tyler Kelley
    - Member at Large IWCA- Tyler Kelley
    - LRTF Grant Advisory Committee-Joseph Kooiker
    - REAP Assembly Member (2019)-Tyler Kelley
  - A tablet was purchased for IRM operations
    - It will be used for tracking work orders, research, and mapping in the field.
  - Staff will start prepping for Spring RX fire in March. Weather, time and resources are always a factor on what can be completed.
  - Spring Planting will be completed off and on throughout burn season. The 13th Street project is currently on hold. 2 bridges, 1 culvert and 1 pipe project planned for FY 2021.
  - Contract spray for brush control is planned for a minimum of 5 townships this year.
    - Townships to be sprayed include: Palestine, Union, Indian Creek, Collins, and Lafayette.
  - Fall 2019 Harvest Update
    - The weather was not ideal for harvesting, high winds and rainstorms knocked seed of the stem early. The conservative estimate of seed harvested was 120 pounds, at an estimated value of \$3,000.